


T.32S. R.6W. W.M.

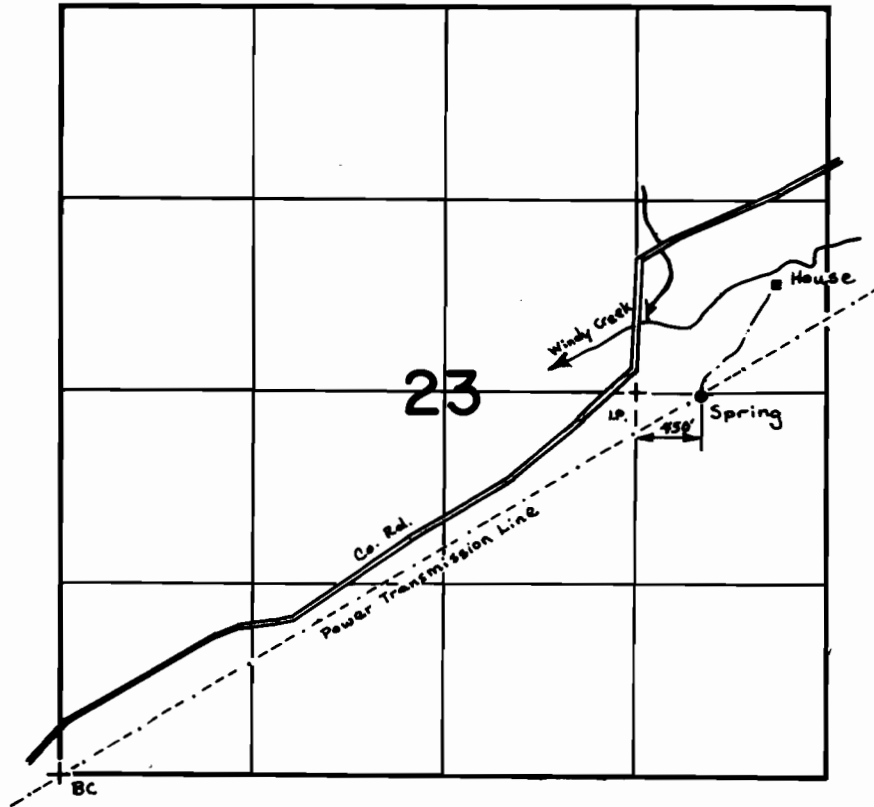

SCALE: 4" = 1 mile

FINAL PROOF SURVEY
UNDER

Application No. 57641 Permit No. 43226
IN NAME OF

FRANK W. & EVELYN R. EARL

Surveyed Jan. 22, 1979, by S. Donaldson