


T.30S. R.2W. W.M.

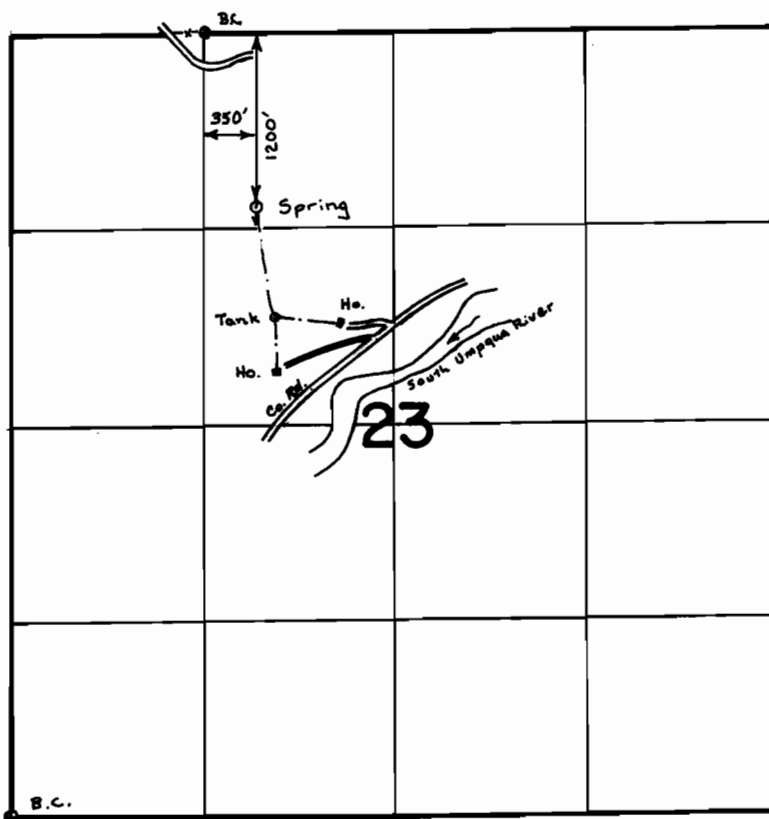

SCALE: 4" = 1 mile

FINAL PROOF SURVEY
UNDER

Application No. 57494 Permit No. 43285
IN NAME OF

CHARLES O. CHEVALIER

Surveyed March 21, 1979, by S. Donaldson.