


T. 26 & 27 S., R. 6 W., W.M.

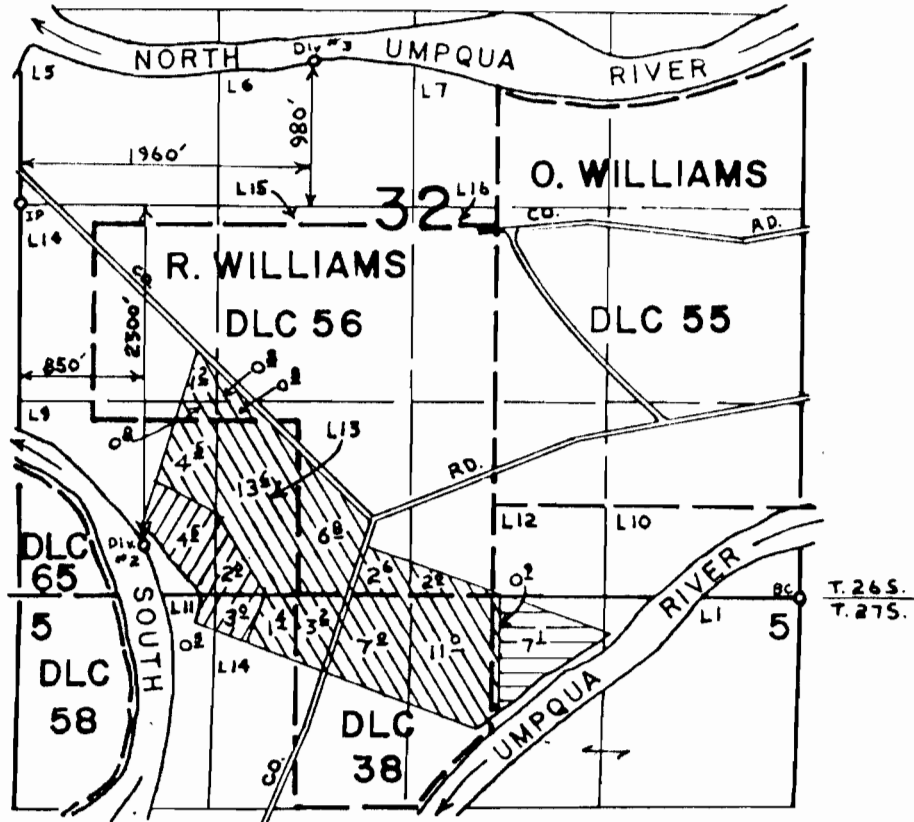

Div. #2
 Over acreage
 Div. #3 (Supplemental)

FINAL PROOF SURVEY UNDER

Application No. 50194... Permit No. 39111.....
IN NAME OF

DON KRUSE

Surveyed MAY 3... 1978, by D.W. SPARKS.....