


T.23 S. R.4 W. W.M.

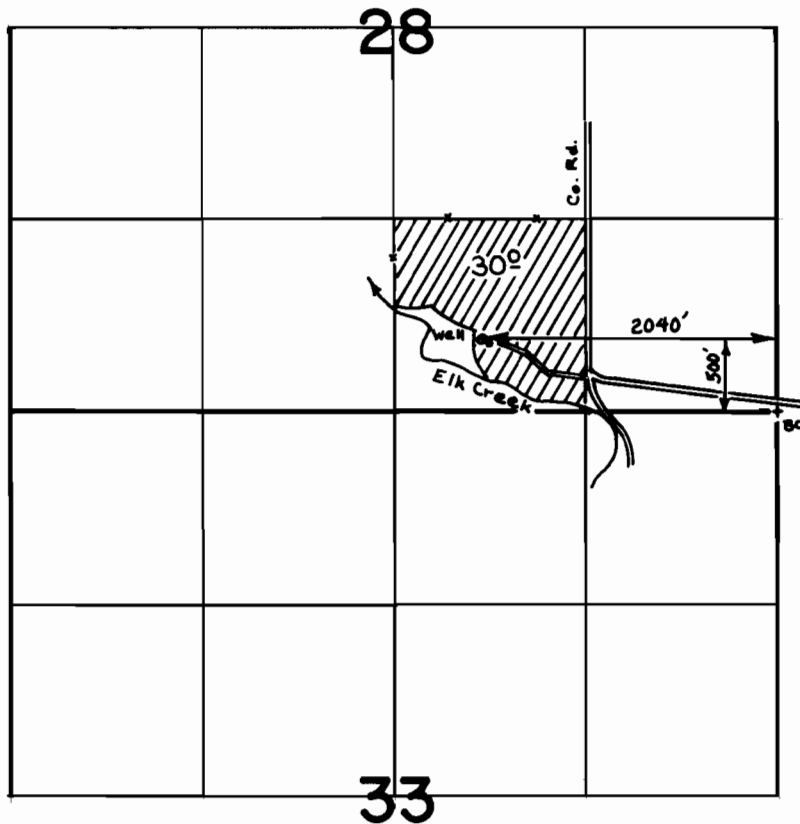

SCALE: 4" = 1 mile

FINAL PROOF SURVEY
UNDER

Application No. G-6440 Permit No. G-6043
IN NAME OF

ERNEST TUCKER

Surveyed Oct. 3 1979, by S. Donaldson.