


T.35 S., R.2 W., W.M.

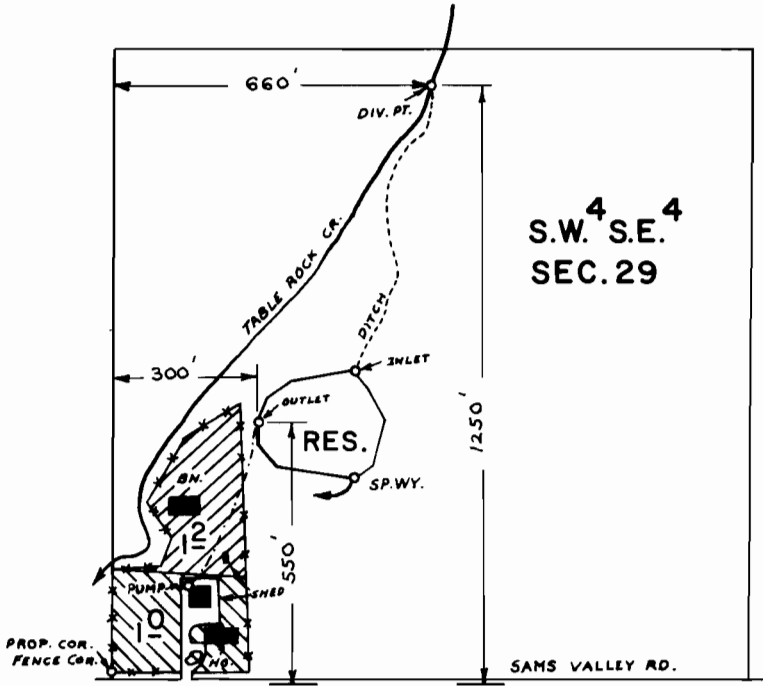

 - PRIMARY
 - SUPPLEMENTAL

SCALE: 1" = 400 FT.

FINAL PROOF SURVEY

UNDER

R-47749 R-5764
Application No. 47750 Permit No. 35767
IN NAME OF

DICK E. OR RITA L. STITT

Surveyed APR. 27 1979, by B. SUND