


T. 35 S., R. 3 W., W.M.:

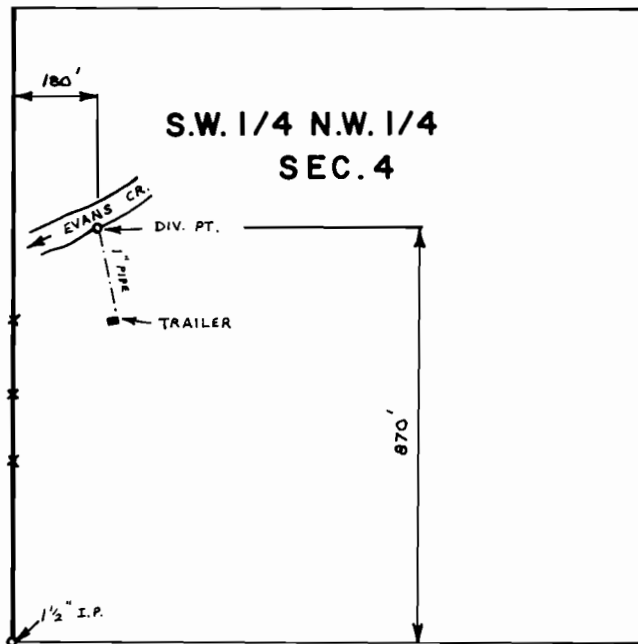

SCALE: 1" = 400 FT.

**FINAL PROOF SURVEY**  
UNDER

Application No. 50742 Permit No. 38324  
IN NAME OF

W. R. BIBBY

Surveyed APR. 30 1979 by B. SUND

D.H.M.  
P.T.S. - 1979 - 14 - A