


T.34 S., R.1 W., W.M.

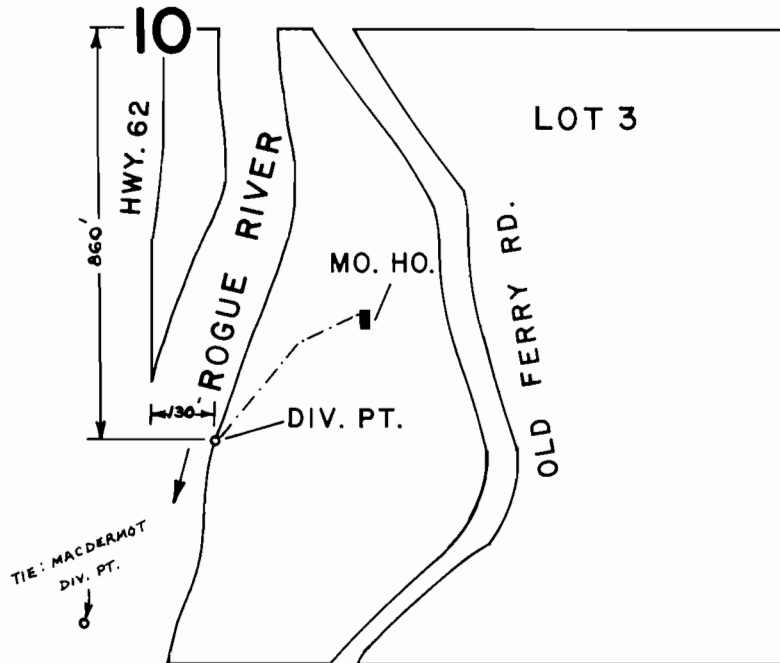

SCALE : 1" = 400 FT.

FINAL PROOF SURVEY UNDER

Application No. 51233 Permit No. 38701
IN NAME OF

ARTHUR R. TEPPER

Surveyed JUN. 20 1979, by B. SUND

D.H.M.
P.T.S. - 1979 - 14 - B
TIE : P.T.S. - 1978 - 14 - D