


T. 34 S., R. 1 W., W. M.

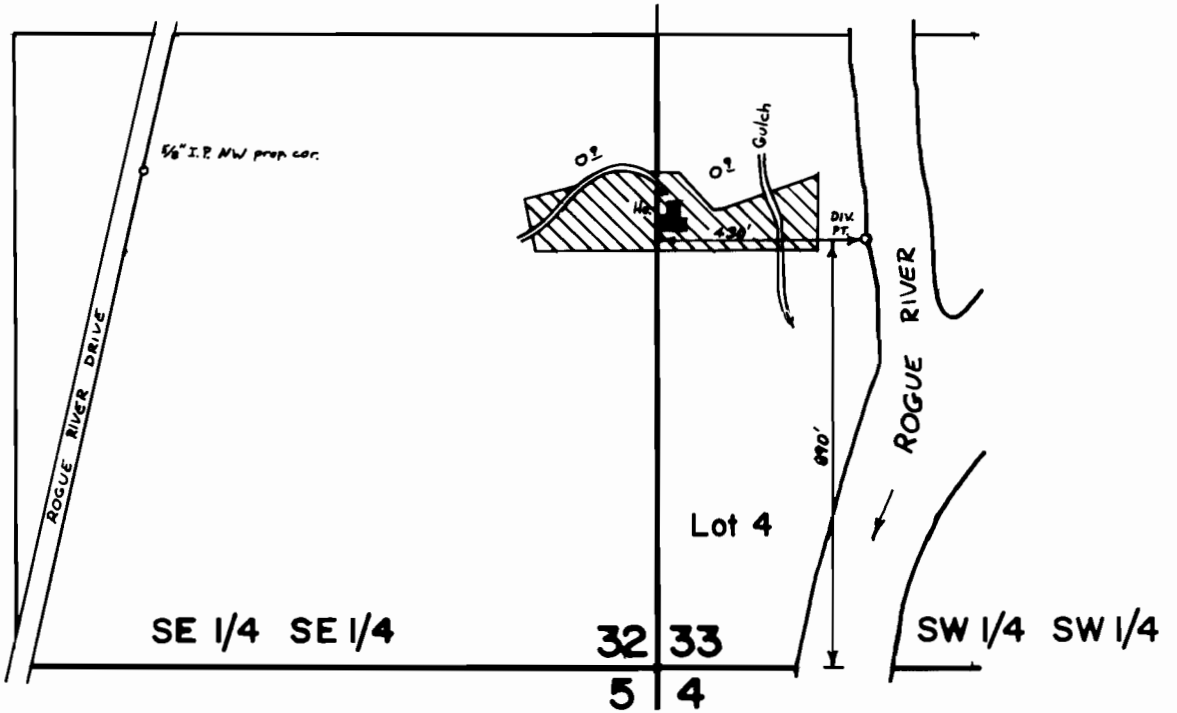

Scale 1" = 400'

**FINAL PROOF SURVEY**  
UNDER

Application No. 53563... Permit No. 40080...  
IN NAME OF  
ESTATE OF CLAUDE S. KERNS  
.....FRANCES KERNS, EXECUTOR.....

Surveyed June 20, 1979, by B.R. SUND.....