


# T. 33 S., R. 2 E., W.M.

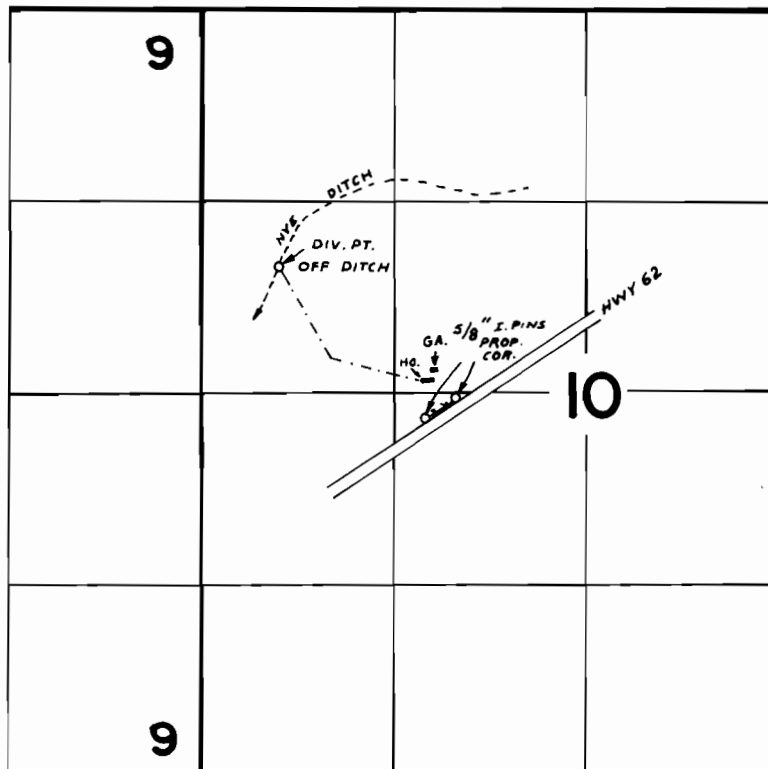

NYE DITCH DIV. PT. LOC. - 590 FT. S. & 100 FT. E.  
FROM THE W. 1/4 COR. OF SEC. 29, T. 32 S., R. 3 E.,  
W. M.

## FINAL PROOF SURVEY UNDER

Application No. 57738 Permit No. 43472  
IN NAME OF

ALVA W. &/OR MARJORIE K. JONES

Surveyed JUN. 7 1979, by B. SUND