


T.38 S., R.4 W., W.M.

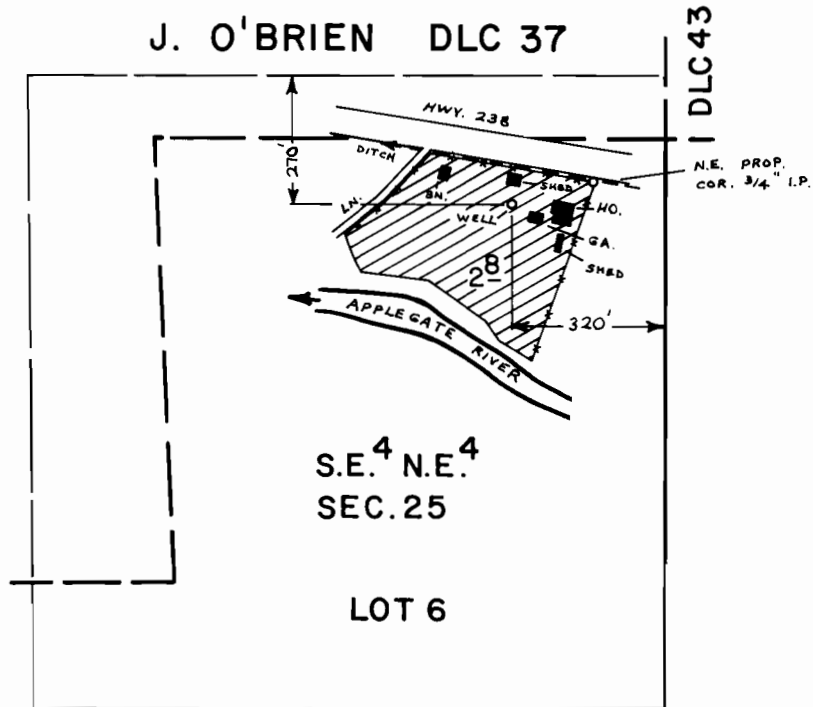

SCALE: 1" = 400 FT.

FINAL PROOF SURVEY
UNDER

Application No. G-8307 Permit No. G-7709
IN NAME OF

ROY E. BRENKMAN

Surveyed MAY 17 1979, by B. SUND

D.H.M.
P.T.S. - 1979-14-B