


T. 39 S., R. 5 W., W. M.

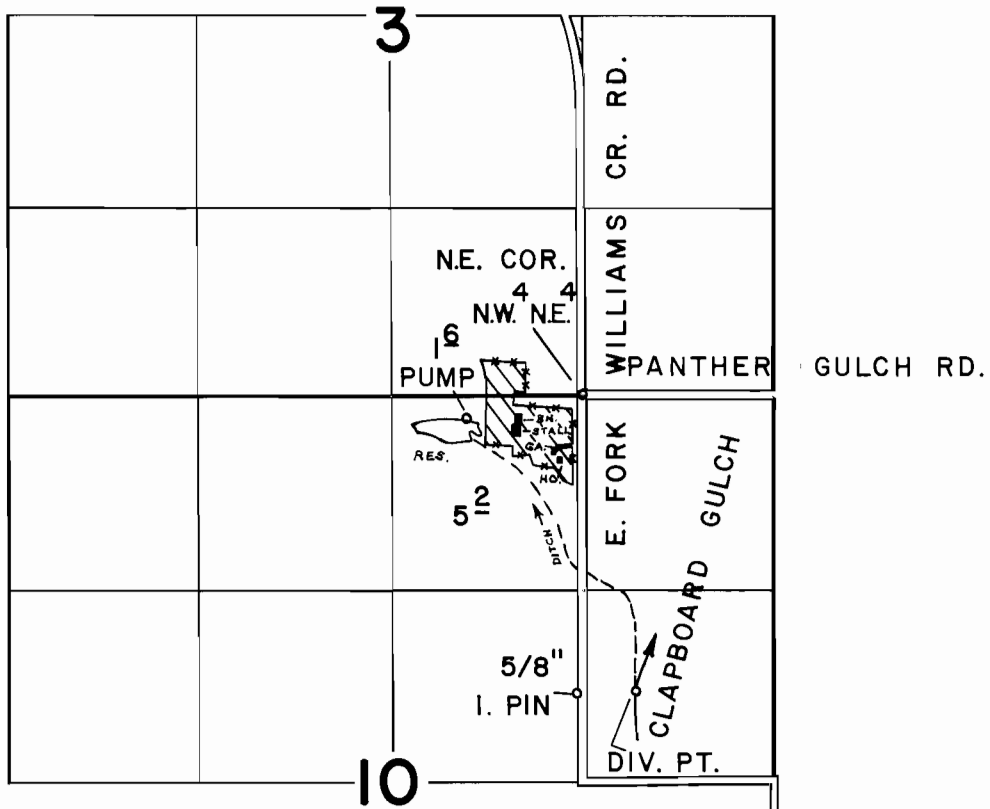

DIV. PT. LOC. - 2030 FT. S. & 350 FT. E., RES. - 150 FT.
 S. & 800 FT. W., BOTH FROM N.E. COR., N.W. 1/4 N.E. 1/4,
 SEC. 10.

FINAL PROOF SURVEY UNDER

Application No. 57202 Permit No. 43012
 IN NAME OF

JOHN J. SPETTER

Surveyed NOV. 9 1978, by B. SUND

D.H.M.

P.T.S. - 1978 - 14 - D
 P.T.S. - 1979 - 14 - A
 P.T.S. - 1961 - V