


T 3N R 10W WM

26

25

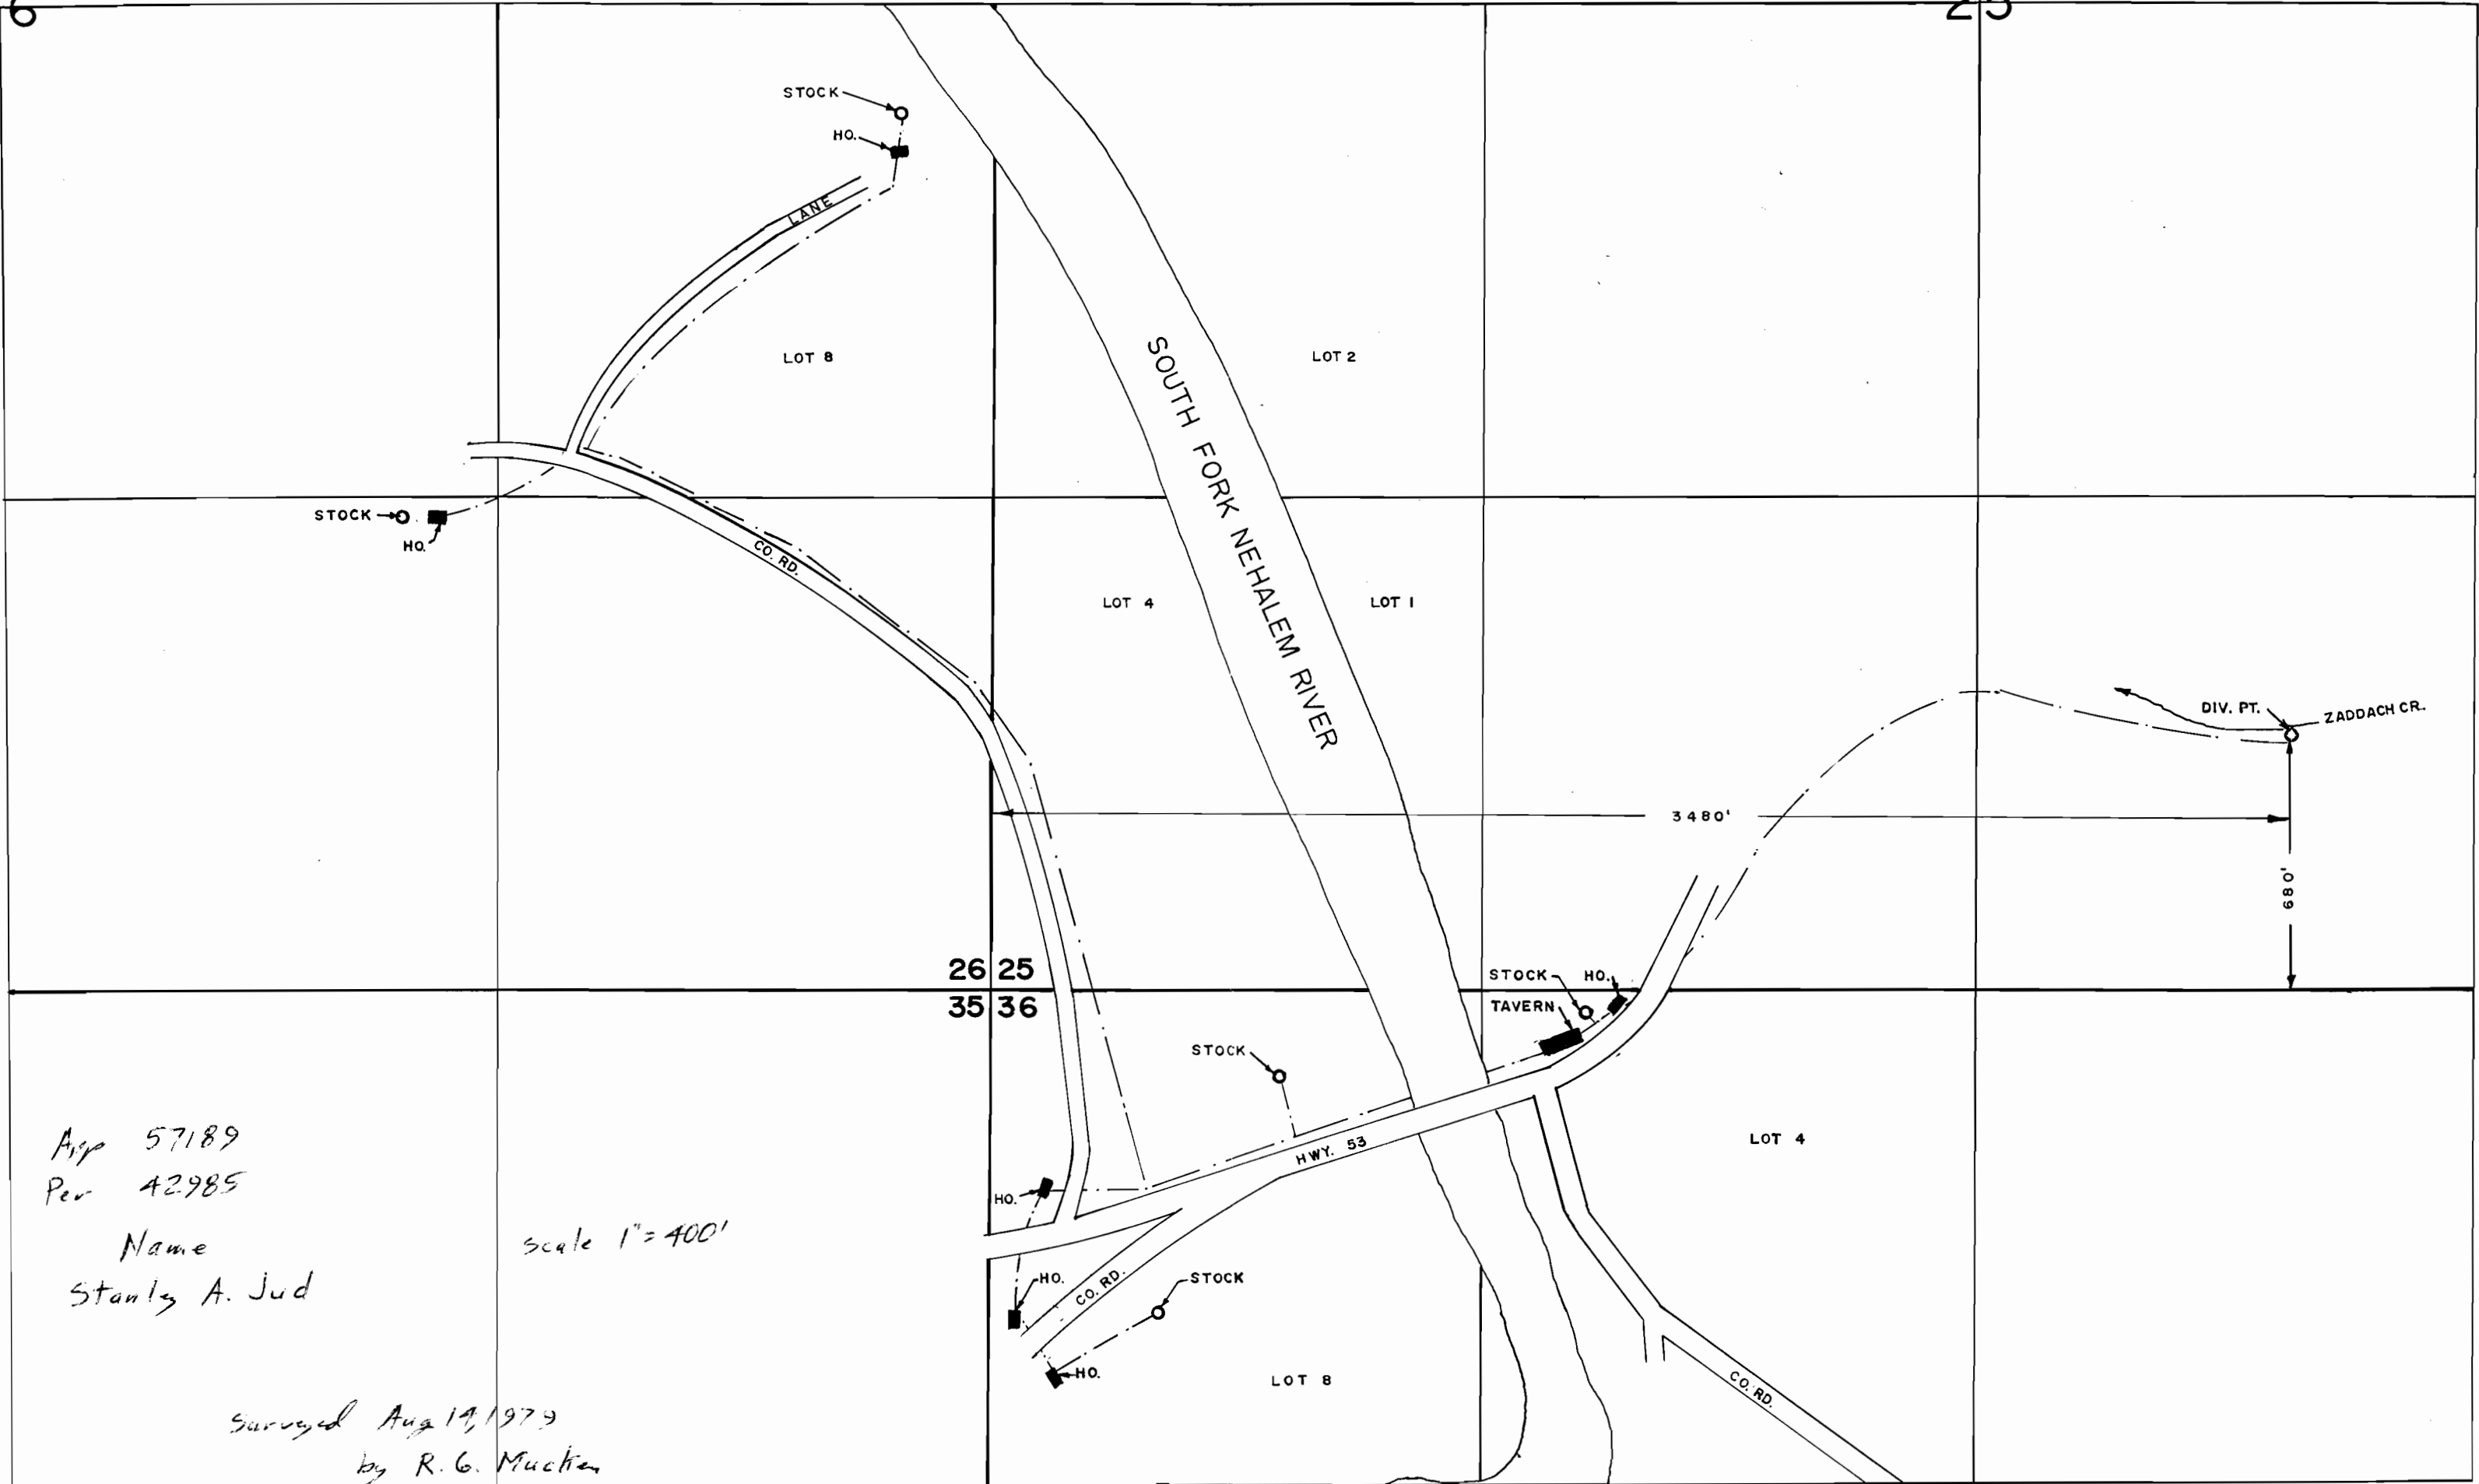

Asp 57189
 Per 42985
 Name
 Stanley A. Jud

Scale 1" = 400'

Surveyed Aug 19, 1979
 by R. G. Muckler

FINAL PROOF SURVEY