


T.I.S.R.4W.W.M.

SCALE 1" = 400'

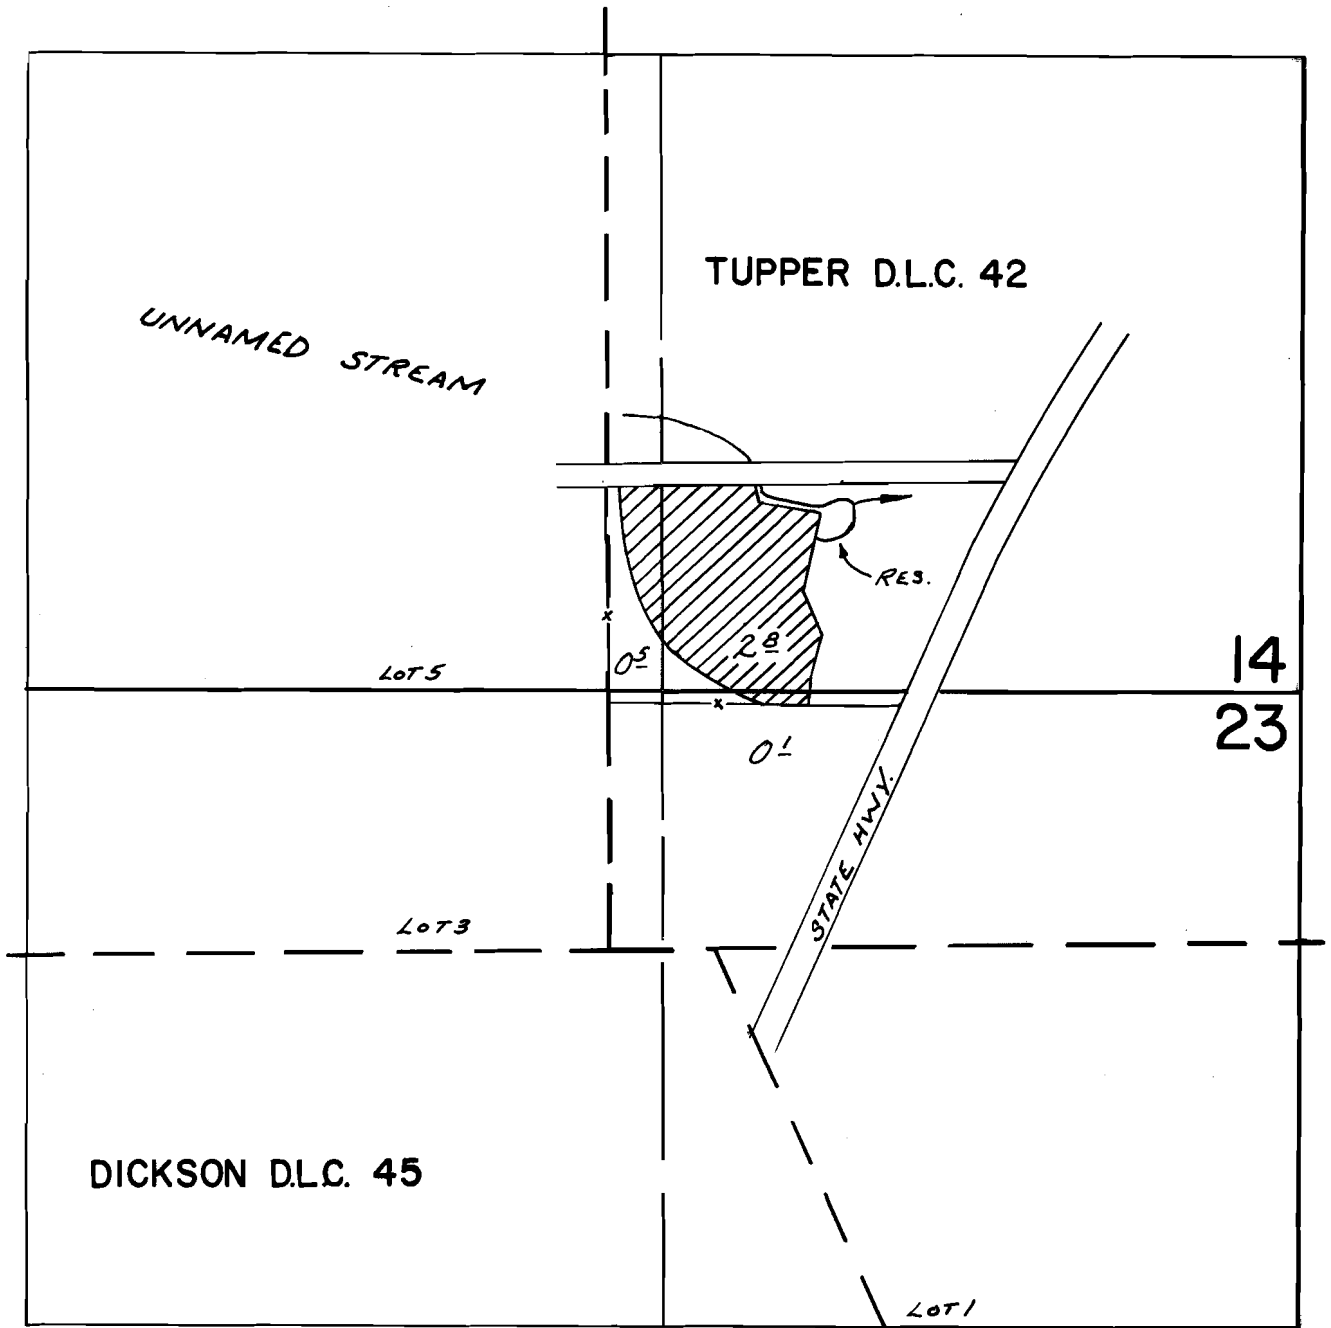

DIV. LOC: 920' N. & 510' E. FROM S.W. COR. TUPPER D.L.C. 42

FINAL PROOF SURVEY

UNDER

Application No. R-51099 Permit No. R-6118
51100 37788
IN NAME OF

RONALD J. KURTH

Surveyed APR. 26, 1979, by R. MUCKEN