


T.2S.R.3W.W.M.

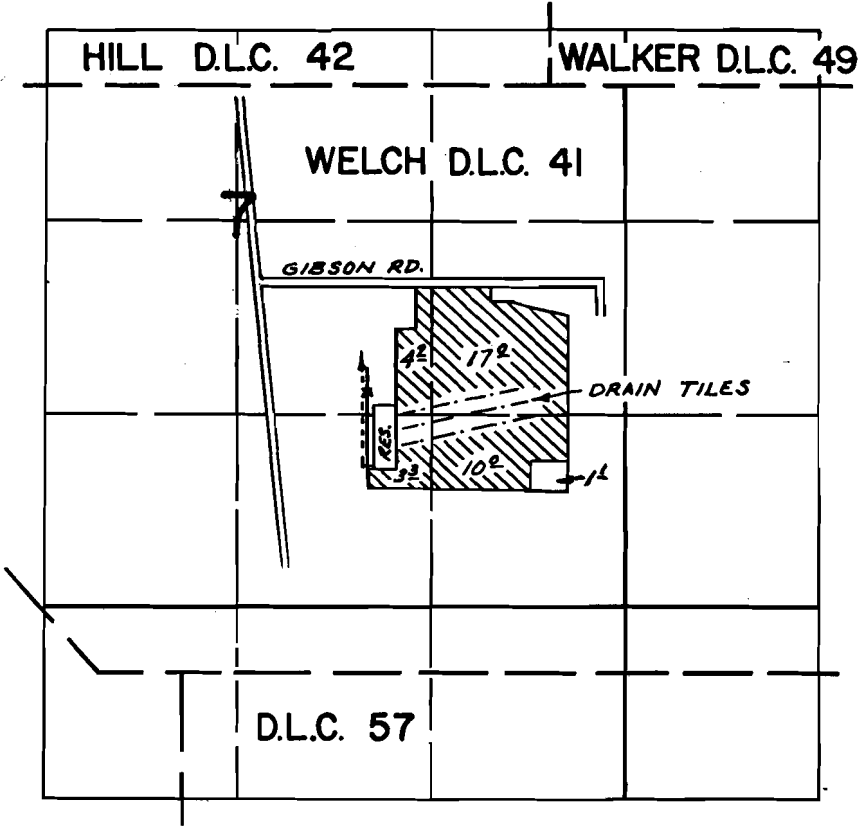

DIV. LOC: 2600'S. & 1160'W. FROM S.E. COR. HILL D.L.C.42

FINAL PROOF SURVEY UNDER

Application No. R-53182 Permit No. R-6173
53539 38229
IN NAME OF

JAMES S. FISHER

Surveyed APR. 26, 1979, by R. G. MUCKEN