


T.2.N.R.3W.W.M.

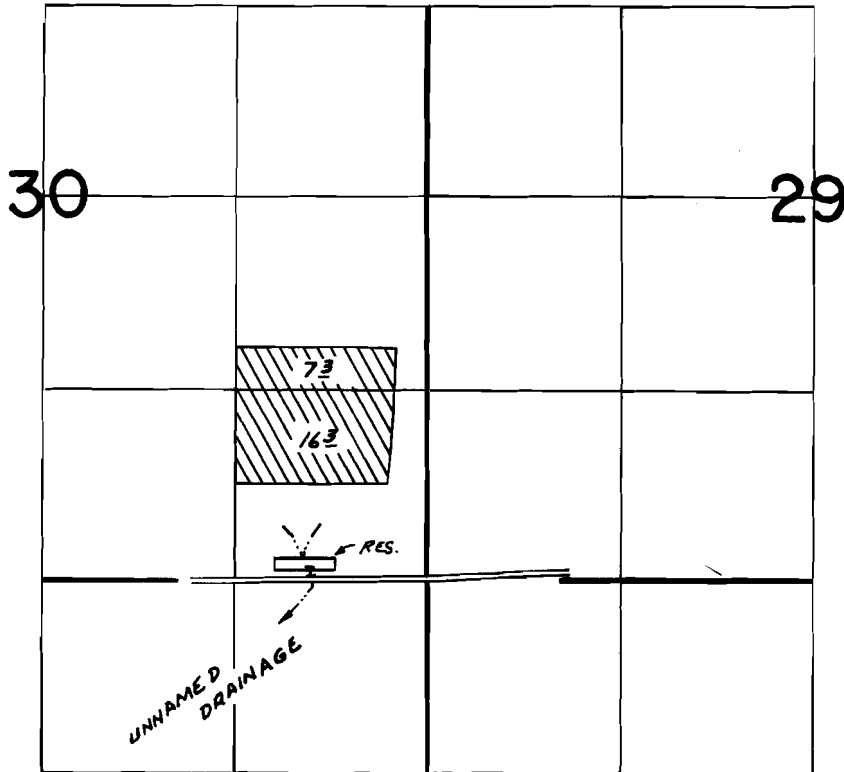

DIV. LOC: 70' N & 780' W. FROM S.E. COR. SEC. 30

FINAL PROOF SURVEY UNDER

R-53477 R-6385
Application No. 53478 Permit No. 39871
IN NAME OF

...ALOYSIUS R. VANDER ZANDEN

Surveyed OCT. 23, 1979, by R. MUCKEN