


T.1S. R.3&4W. W.M.

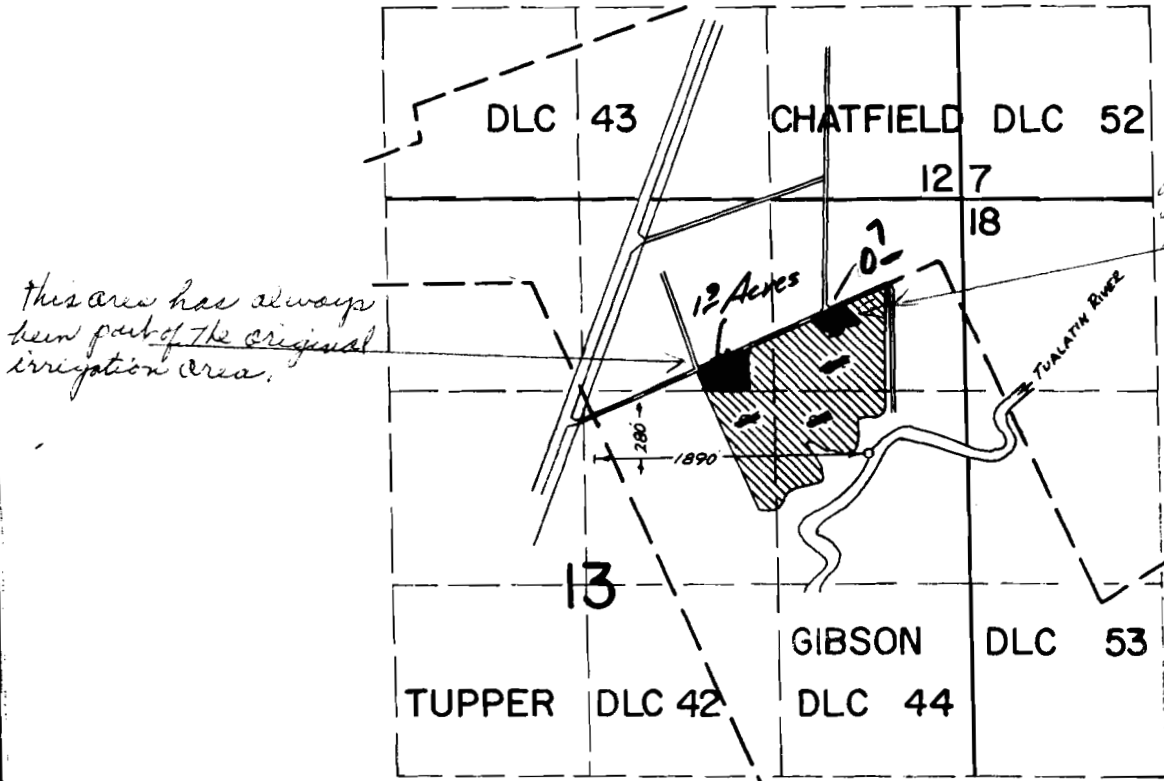

This area was much larger as an old house & yard once it as here. This should be indicated in red. 1.9 acres

This area has always been part of the original irrigation area.

RECEIVED
 JAN 21 1977
 WATER RESOURCES DEPT
 SALEM, OREGON

Application No. 54817
 Permit No. 41233

FINAL PROOF SURVEY
 UNDER

RECEIVED
 SEP 24 1976
 WATER RESOURCES DEPT
 SALEM, OREGON

~~Application No. 47027 Permit No. 35179~~
 IN NAME OF

~~CASEY E. NUTSCH~~

~~Surveyed Sep 6 1974 by R. G. MUCKEN~~