


T.2N.R.3W.W.M.

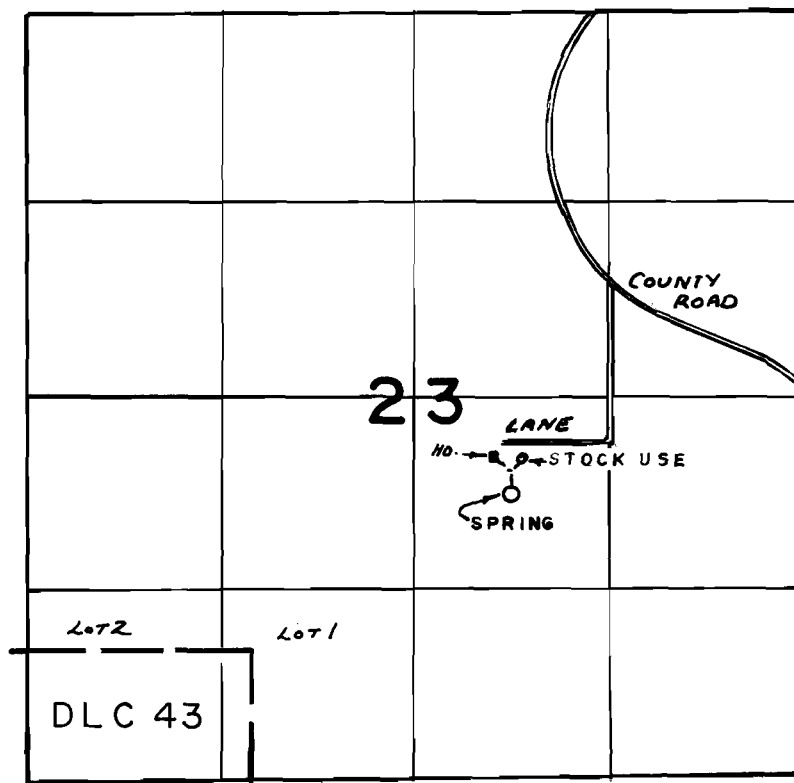

SPRING LOC.: 680'S. & 650'E. FROM CEN. SEC. 23

FINAL PROOF SURVEY
UNDER

Application No. 57060 Permit No. 42919.....
IN NAME OF

A. J. KRUEGER

Surveyed OCT. 23 1979 by R. G. MUCKEN...