

T-3982

THIS MAP PREPARED BY:

Flora Ford


FROM INFORMATION FURNISHED BY  
THE APPLICANT.

T.18.2S.R.4W.W.M.

**RECEIVED**

JUN 21 1978

WATER RESOURCES DEPT.  
SALEM, OREGON

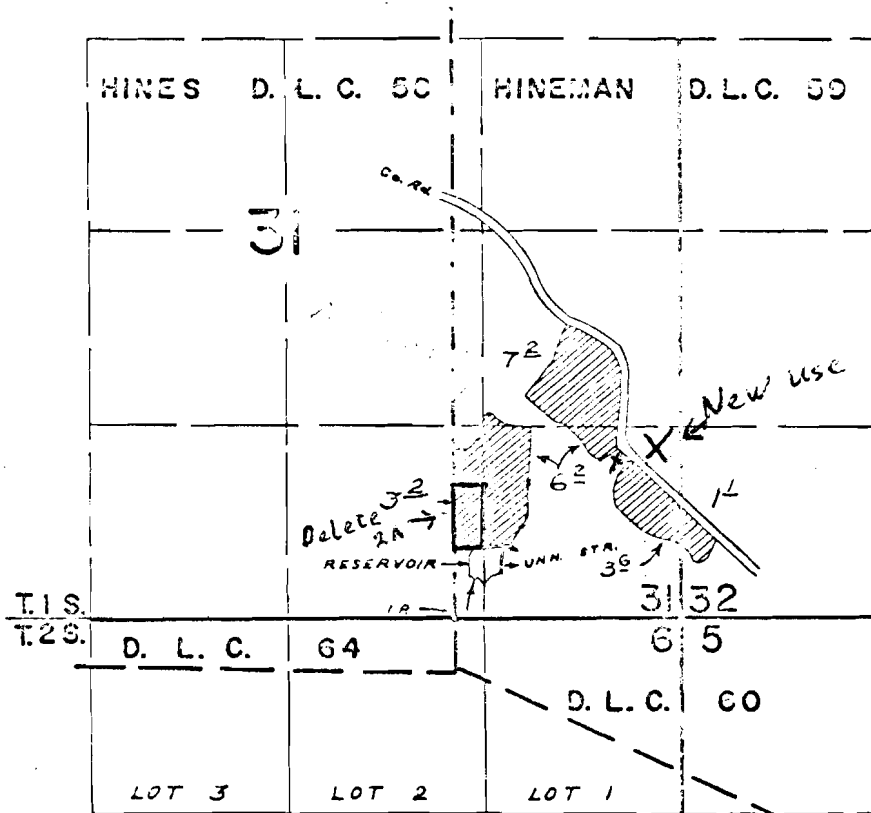

DIV. PT. LOCATED 350' N & 310' E FROM SW COR.  
HINEMAN D.L.C. "59"

Application No. 57556

Permit No. 43571

**FINAL PROOF SURVEY**  
UNDER

R-40854 R-4519  
Application No. 40435 Permit No. 50155  
IN NAME OF

JOHN MULHOLLAND

Surveyed OCT. 8 1968, by W. J. RUPPERT