


# T.2S.R.4W.W.M.

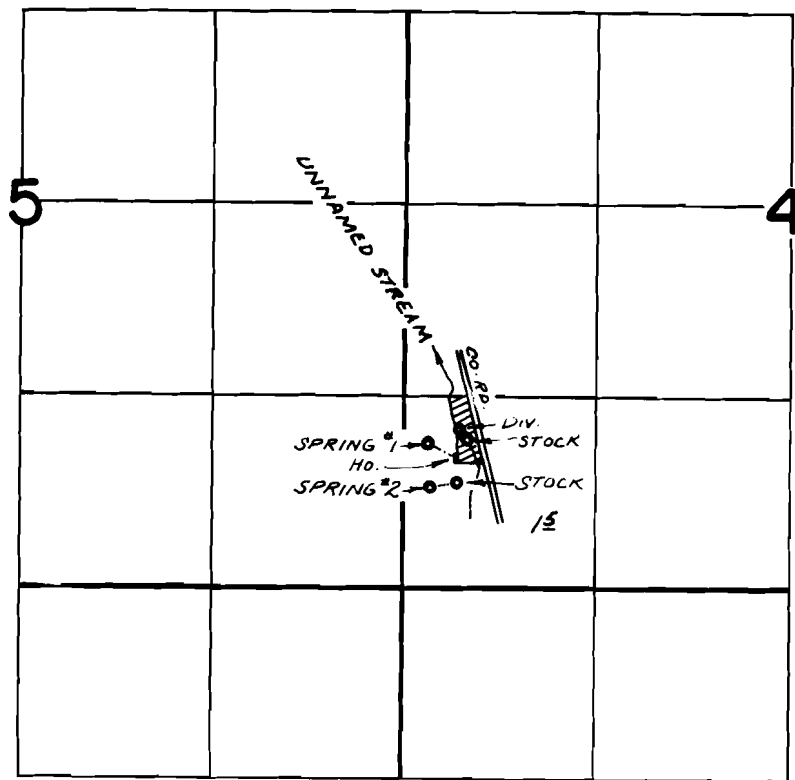

DIV. PTS LOC: SPRING #1 - 1000'N. & 160'E.  
SPRING #2 - 700'N. & 180'E.  
UNNAMED STREAM - 1100'N. & 380'E, ALL  
FROM S.W. COR. SEC. 4

## FINAL PROOF SURVEY

UNDER

Application No. 58192.. Permit No. 93961....  
IN NAME OF

ROY...ALLEN...& VIRGINIA...LOUISE...HERGERT

Surveyed OCT. 22, 1979, by R.G. MUCKEN