


T. 30 S., R. 11 W., W.M.

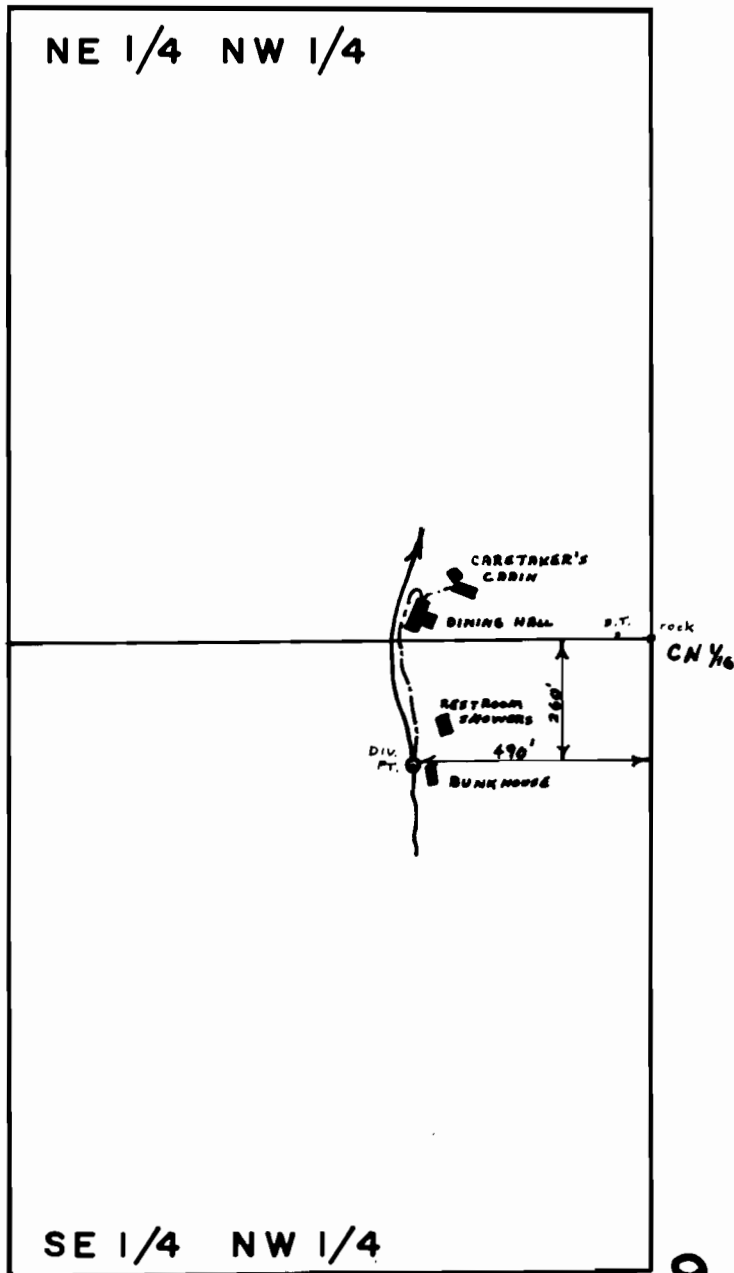

SE 1/4 NW 1/4

SCALE: 1" = 400'

FINAL PROOF SURVEY
UNDER

Application No. 4.7.15.4.. Permit No. 35303..
IN NAME OF
CAMP MYRTLEWOOD INC.
...CHURCH...OF...THE...BRETHREN.....

Surveyed SEPT. 25, 1979, by S. DONALDSON