


T. 29 S. R. 12 W. W.M.

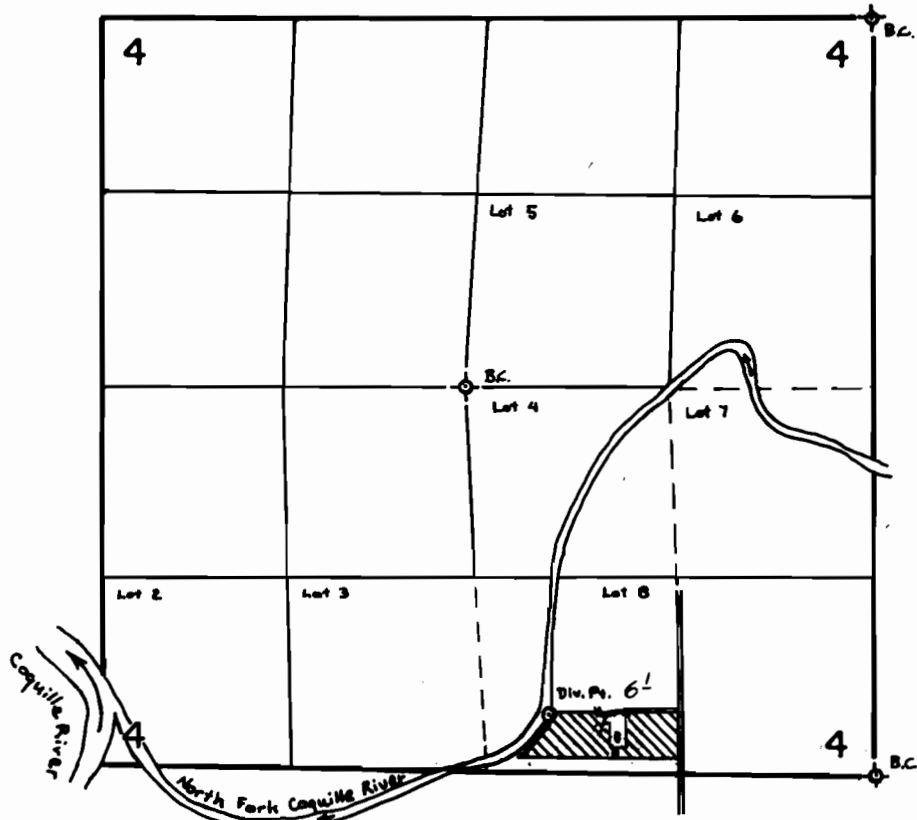

Div. Pt. Located: 400' N & 2230' W from the SE cor. of Sec. 4

SCALE: 4" = 1 mi.

**FINAL PROOF SURVEY
UNDER**

Application No. 49943 Permit No. 37566
IN NAME OF

FRANK E. CHRISTENSEN

Surveyed May 17, 1978, by D. Sparks