


T.29S. R.IIW. W.M.

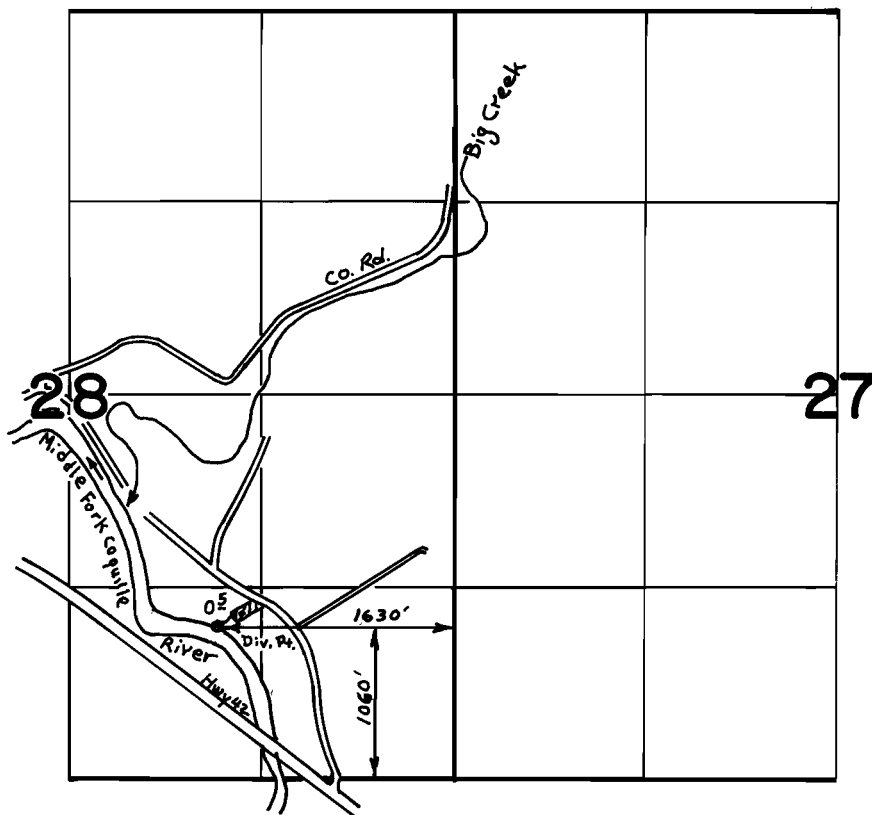

SCALE: 4" = 1 mile

FINAL PROOF SURVEY
UNDER

Application No. 51340 Permit No. 38757
IN NAME OF

DAVID R. COOPER

Surveyed Sept. 25, 1979, by S. Donaldson