


T. 28 S., R. 13 W., W.M.

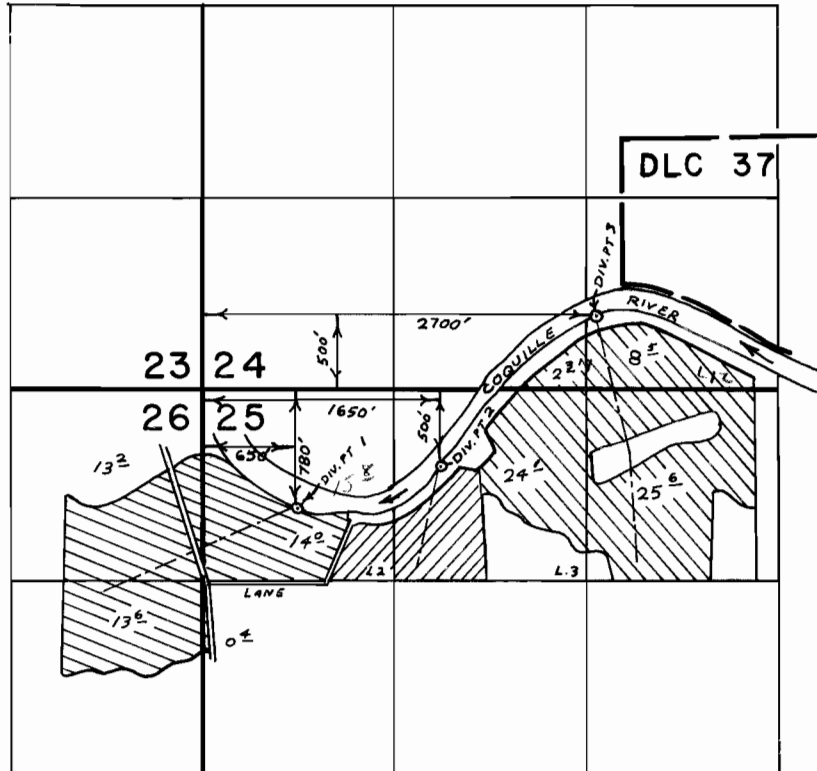

SCALE 4" = 1 mile

FINAL PROOF SURVEY UNDER

Application No. 53184... Permit No. 38796..
IN NAME OF

.....ADRIAN.....C.....HALTER.....

Surveyed April 19, 1978, by Bruce R. Sund