


T.27S., R.13W., W.M.

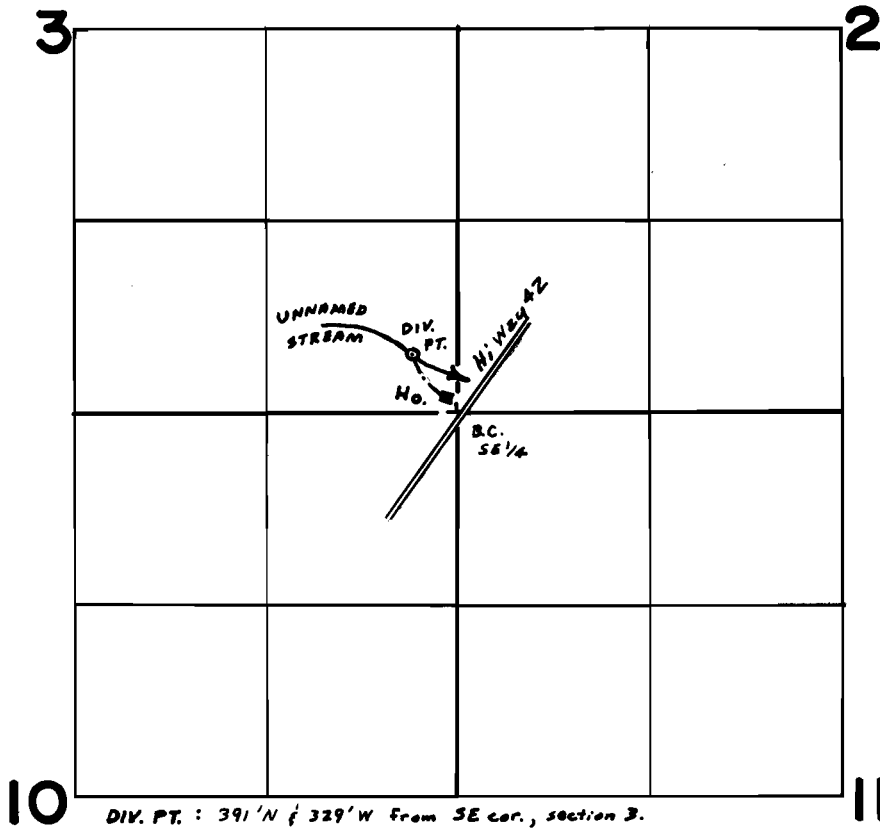

SCALE : 4" = 1 mile

FINAL PROOF SURVEY
UNDER

Application No. 51372... Permit No. 38848...
IN NAME OF

.....AUBY.....WEBER.....SPENCE.....

Surveyed April 20, 1978, by B.R. SUND.....