


T.29S. R.11W. W.M.

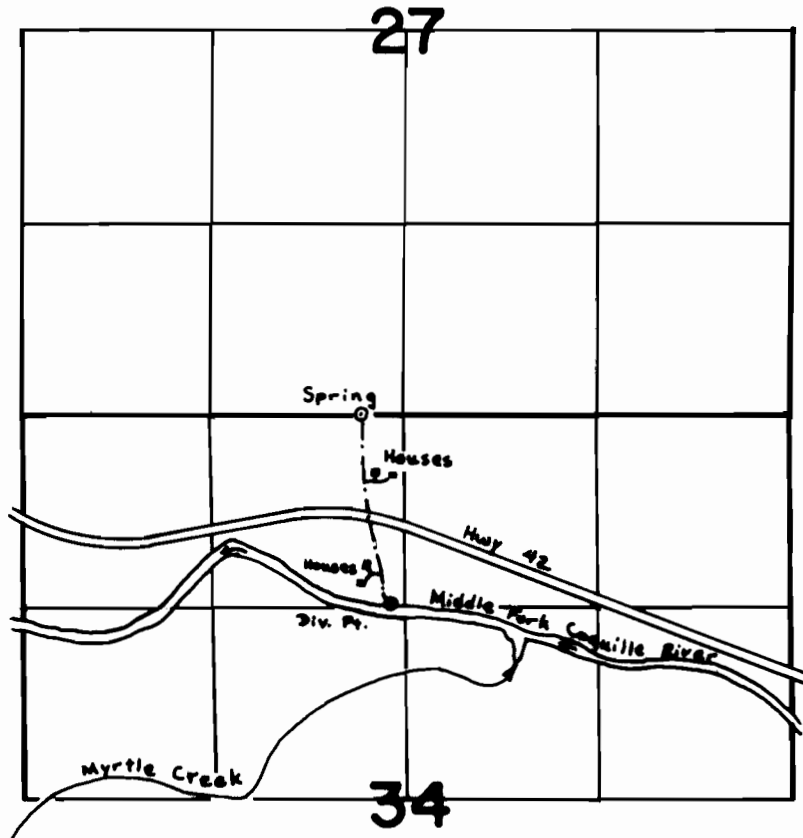

Spring Located: 290' W from N¹/₄ cor. Sec. 34
Div. Pt. Located: 1320' S & 100' W from N¹/₄ cor. Sec. 34

SCALE: 4" = 1 mile

**FINAL PROOF SURVEY
UNDER**

Application No. 51944 Permit No. 39076
IN NAME OF

IVAN A. & CONNIE M. PATTERSON

Surveyed Aug. 8 1978, by D. Sparks