


T 27 S. R. 12 W. W.M.

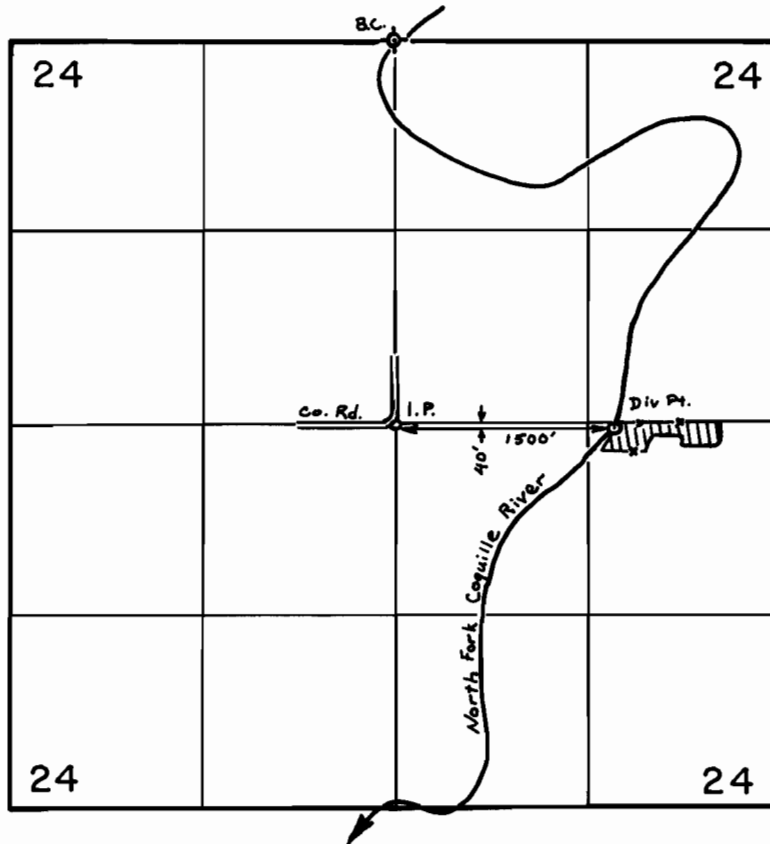

SCALE: 4" = 1 mi.

FINAL PROOF SURVEY
UNDER

Application No. 52384 Permit No. 39409
IN NAME OF

JACK FREDERICKSEN

Surveyed May 15 1978, by D. Sparks