


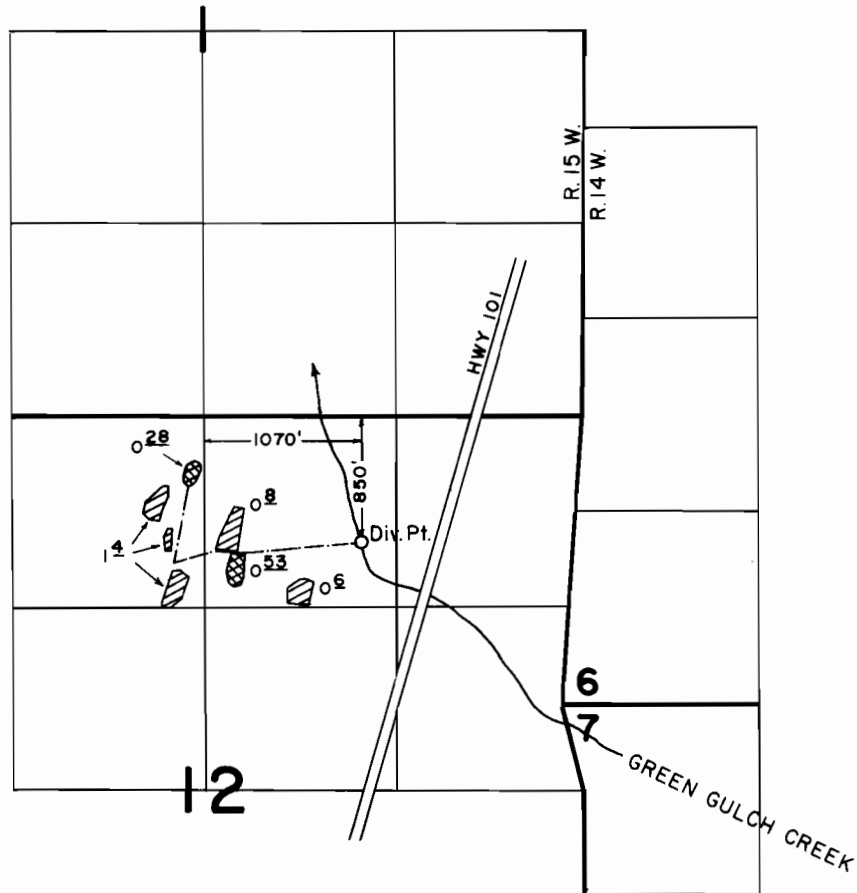

T. 30 S., R. 14 & 15 W., W.M.



SCALE: 1" = 1320'

FINAL PROOF SURVEY
UNDER

 Irrigation
 Temperature Control
& Harvesting

Application No. 52521... Permit No. 41306...
IN NAME OF

WILLIAM S. & IRIS A. LOSHBAUGH

Surveyed JUNE 13, 1979, by J. S. DONALDSON

5-8-90
30 S-15 W NE

gcl