


**T. 28 S., R. 12 W., W.M.**

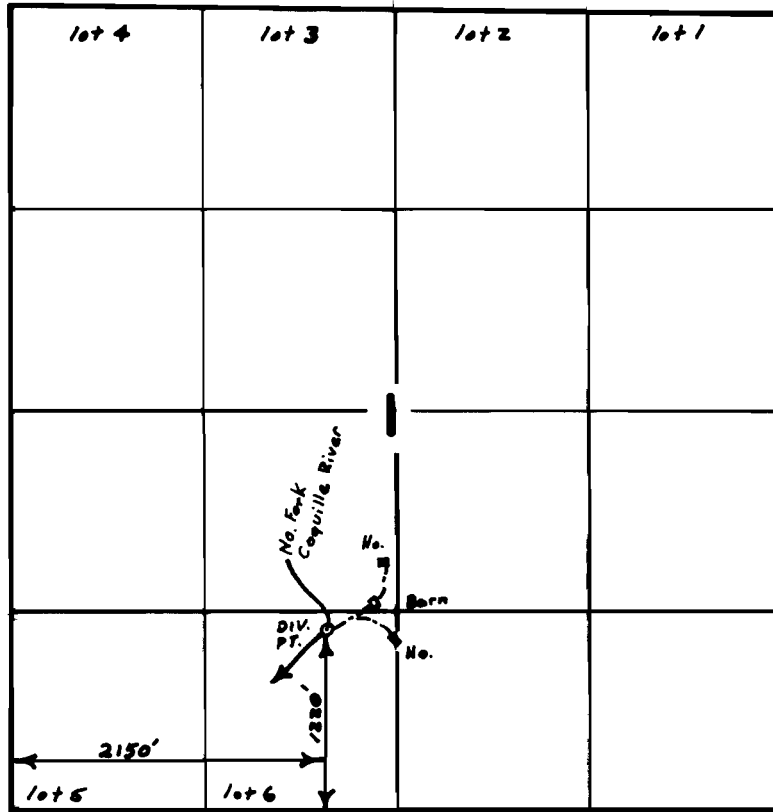

SCALE : 4" = 1 mile

**FINAL PROOF SURVEY  
UNDER**

Application No. 55651 Permit No. 41690  
IN NAME OF

..... LLOYD K. MAST .....

Surveyed O.C.T. ... 11, 19.7.9, by S. DONALDSON