T.28S. R.13&14W. W.M.

Application No. 57405
Permit No. 13194

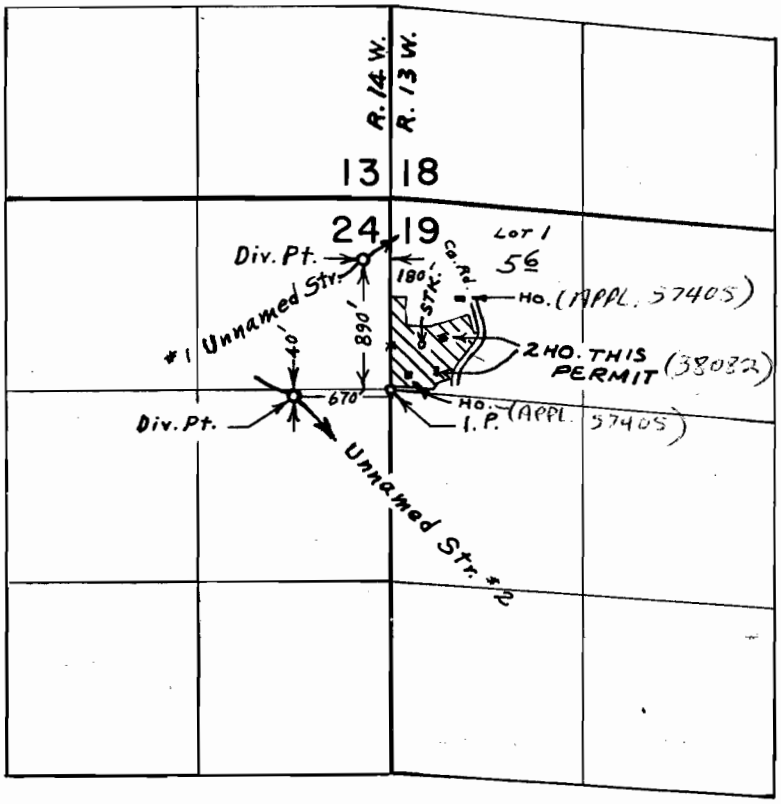

FINAL PROOF SURVEY
UNDER

Application No. ~~50042~~ Permit No. ~~38082~~
IN NAME OF
FRANCES & HARLIS GARDNER

~~Surveyed July 19, 1976, by L. E. Gould.~~

1976-L