


T. 27S., R. 13 W., W.M.

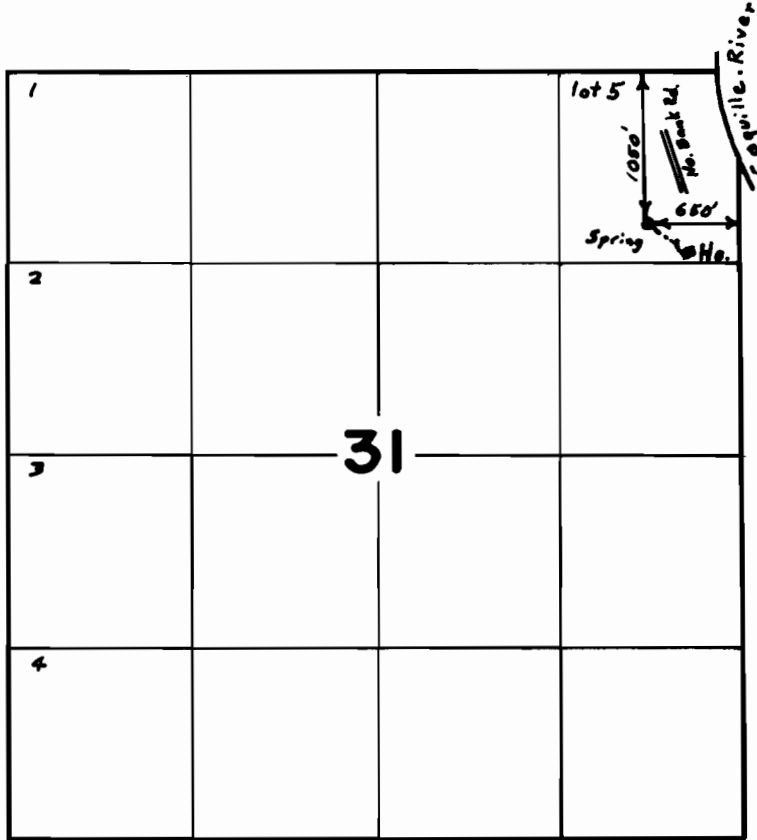

SCALE : 4" = 1 mile

FINAL PROOF SURVEY
UNDER

Application No. 5785B.. Permit No. 43797..
IN NAME OF

.....JOSEPH.....SCOTT.....SHELY.....

Surveyed 9-12.... 1979, by S..DONALDSON