


T. 28 S., R. 14 W., W.M.

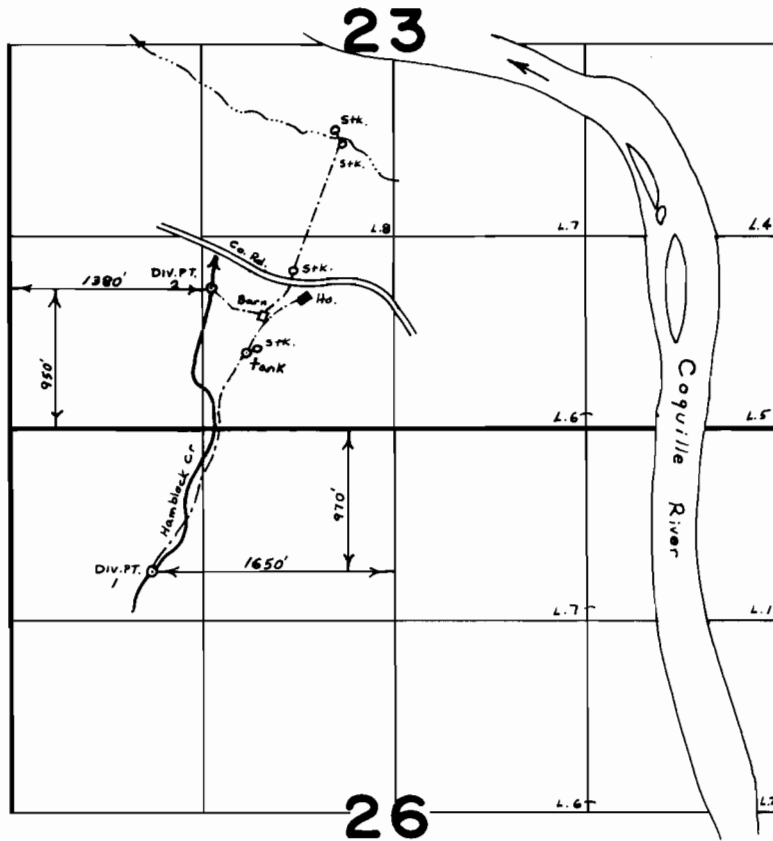

SCALE 4" = 1 mile

FINAL PROOF SURVEY
UNDER

Application No. 5.8229 Permit No. 4.3952...
IN NAME OF

...W.S...B...FRANCES.....NEWTON.....

Surveyed June.13, 1979, by S...Donaldson..