


T. 14 S. R. 15 E. WM

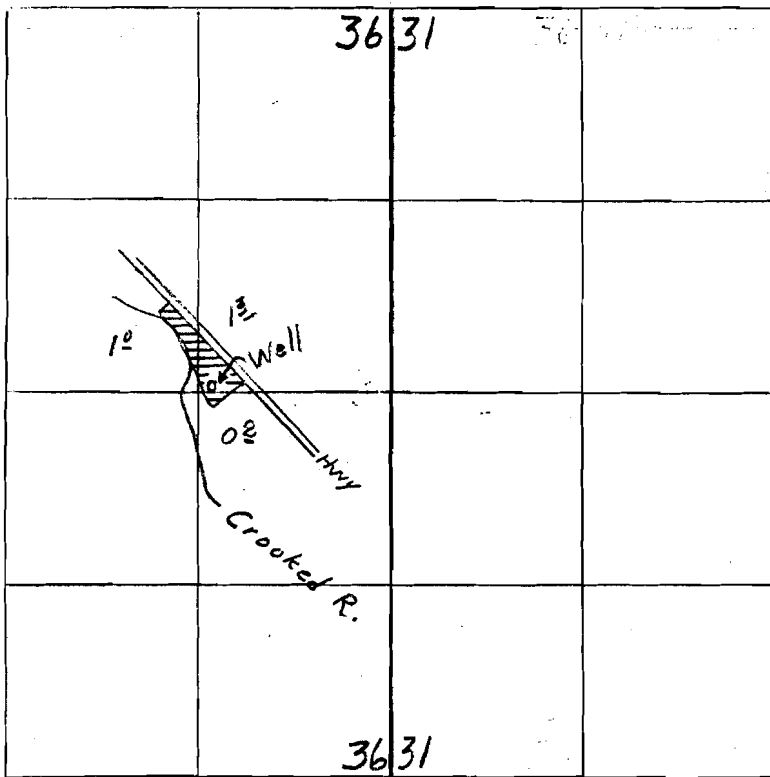

Final Proof Survey  
Under

Application U-160 Permit U-153  
In name of

L. R. Lynam

Surveyed April 23 1956 by T. Jones

U-153  
DCYBH 139