


T.32S. R.15W. W.M.

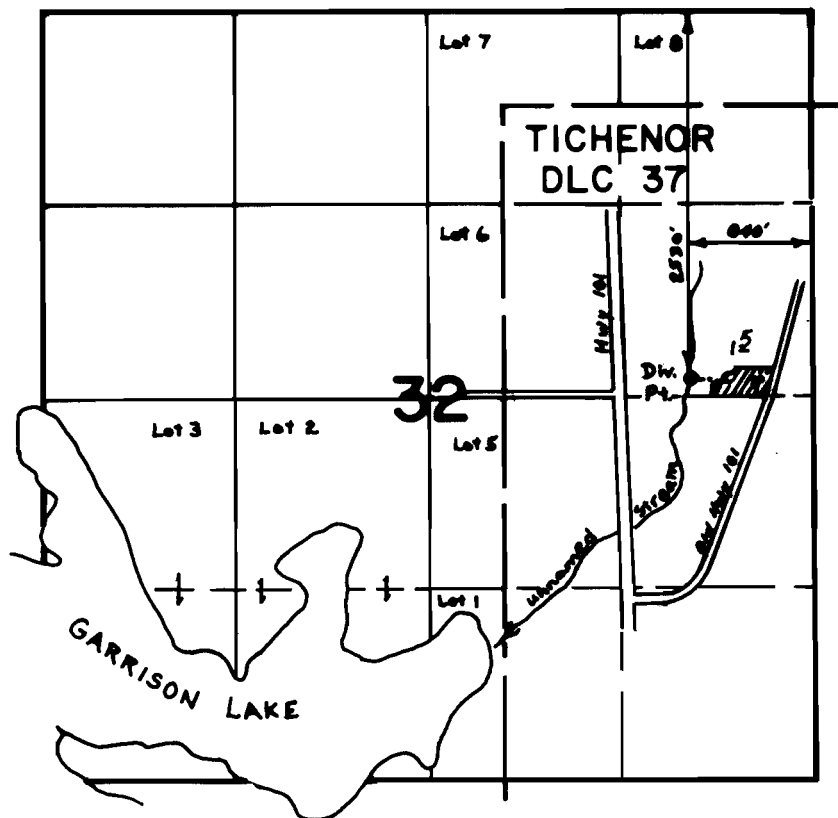

SCALE: 4" = 1 mile

FINAL PROOF SURVEY
UNDER

Application No. 54267 Permit No. 40640
IN NAME OF

DONALD & FRANCES FOSTER

Surveyed June 25, 1979, by S. Donaldson