

33 S
15 W

RECEIVED

APR 18 1977
WATER RESOURCES DEPT
SALEM, OREGON




WENDELL & Gladys A. MORAN
house No. 30, "Hamlet"
Tax Lot No. 1100, Curry County Map No. 33:15:58A

PLAT OF THE HAMLET CURRY COUNTY, OREGON Scale 1 inch = 100 feet

RECEIVED

MAR - 1977
WATER RESOURCES DEPT
SALEM, OREGON

Application No. 55394
Permit No. 41536

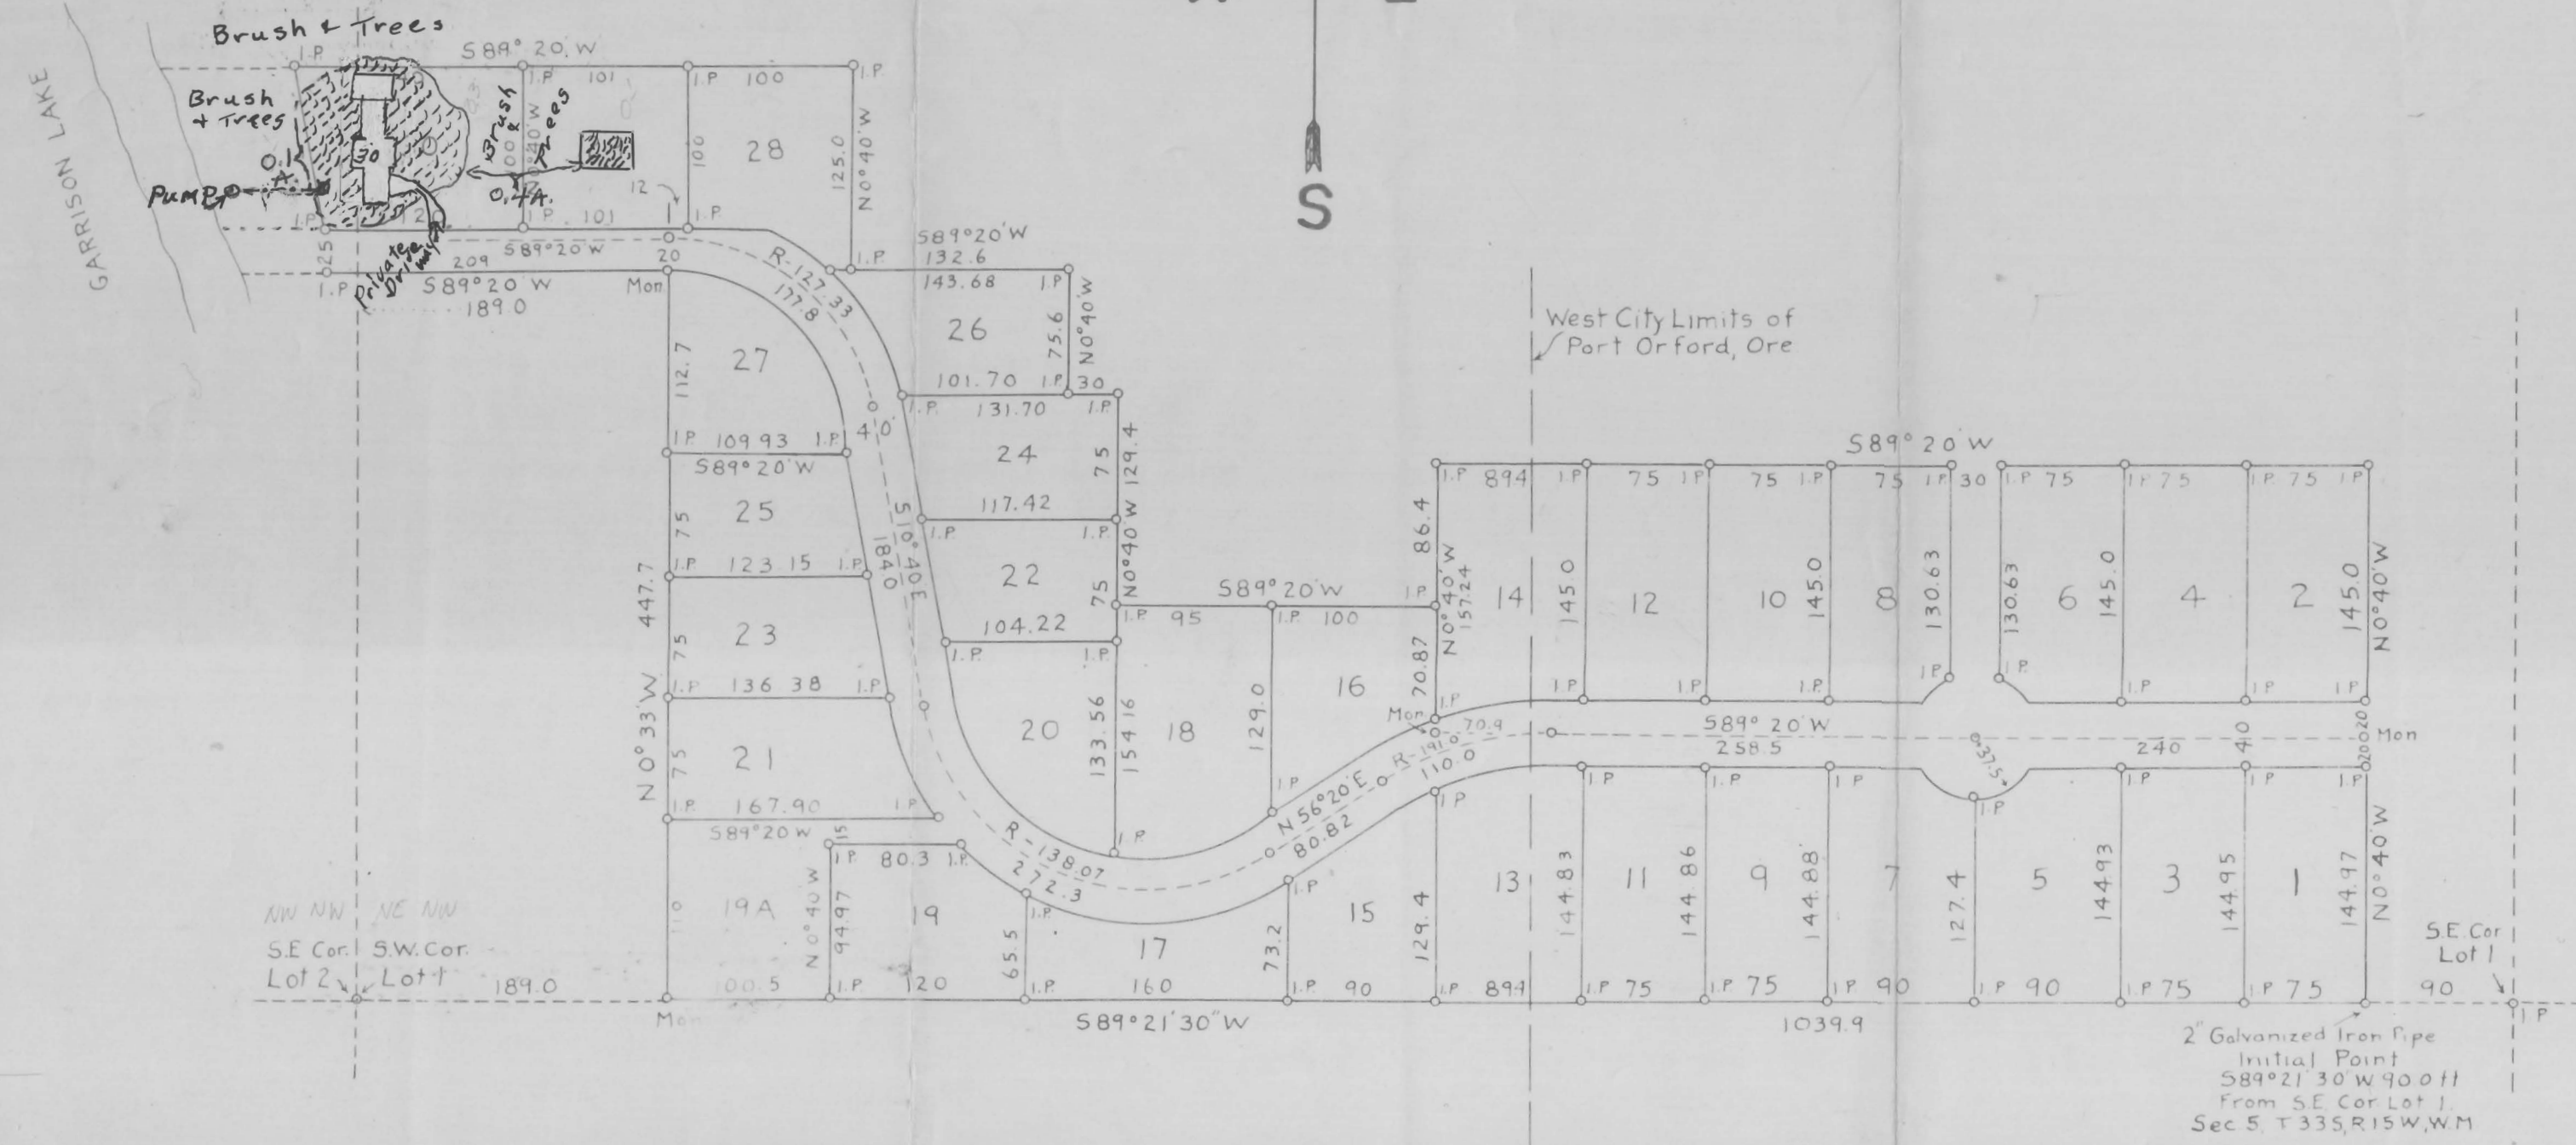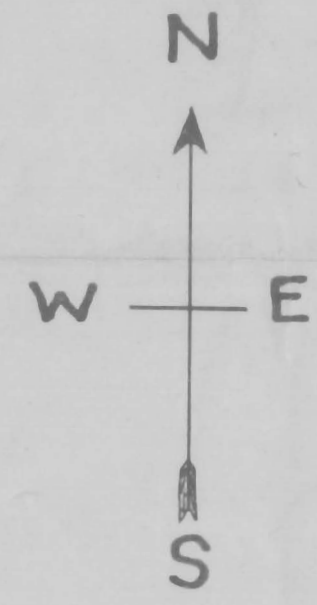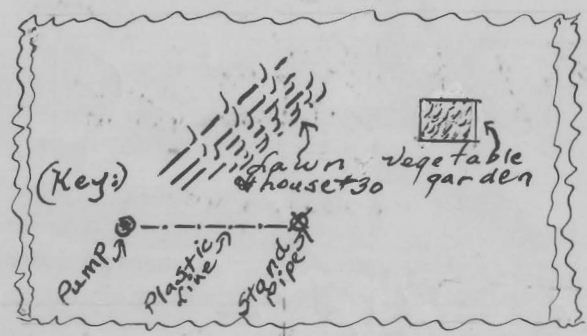

Know all men by these presents that the Trans-Pacific Lumber Company, a corporation, does hereby dedicate to the public for use as highways the roads shown on this Plat. In witness whereof the Trans-Pacific Lumber Company has caused these presents to be executed by its President by authority of its Board of Directors and its corporation seal affixed this 10th day of November, 1942. In presence of J. M. Runk Trans-Pacific Lumber Company By A. S. McRuffe President

State of California } ss
County of Sacramento }
On this 10th day of November AD 1942, before me appeared A. S. McRuffe, to me personally know, who being sworn did say that he is President of the Trans-Pacific Lumber Company, and that the Seal affixed to said instrument is the Corporate Seal of said Corporation and that said instrument was signed and sealed in behalf of said Corporation by authority of its Board of Directors and said A. S. McRuffe acknowledged said instrument to be the free act and deed of said Corporation. In testimony whereof I have set my hand and affixed my official seal on this 10th day of November AD 1942. [Signature] Notary Public for Sacramento My Commission Expires November 2, 1945

State of Oregon } ss
County of Curry }
I, S. O. Newhouse, being duly sworn, say that I am a surveyor by occupation, That I have surveyed the land embraced in the accompanying Plat. That I have correctly surveyed and marked with proper monuments the land represented in said Plat, and as marked thereon. That I planted a 2 inch galvanized iron pipe monument indicating the initial point of said survey and that the same is South 89°21'30" West 90 feet from the Southeast Corner of Lot 1, Section 5, Township 33 South, Range 15 West of the Willamette Meridian.

Subscribed and sworn before me this 20 day of November, 1942
[Signature] Notary Public for Oregon
My Commission Expires 1-2-46
Approved [Signature] County Judge
[Signature] Commissioner
[Signature] Commissioner
Approved [Signature] Assessor
[Signature] County Surveyor
All taxes on above land are paid
[Signature] Sheriff
Attest [Signature] County Clerk

FILED
Dec. 2nd, 1942
[Signature]

