


# T.26S., R.5W., W.M.

## SECTION 7

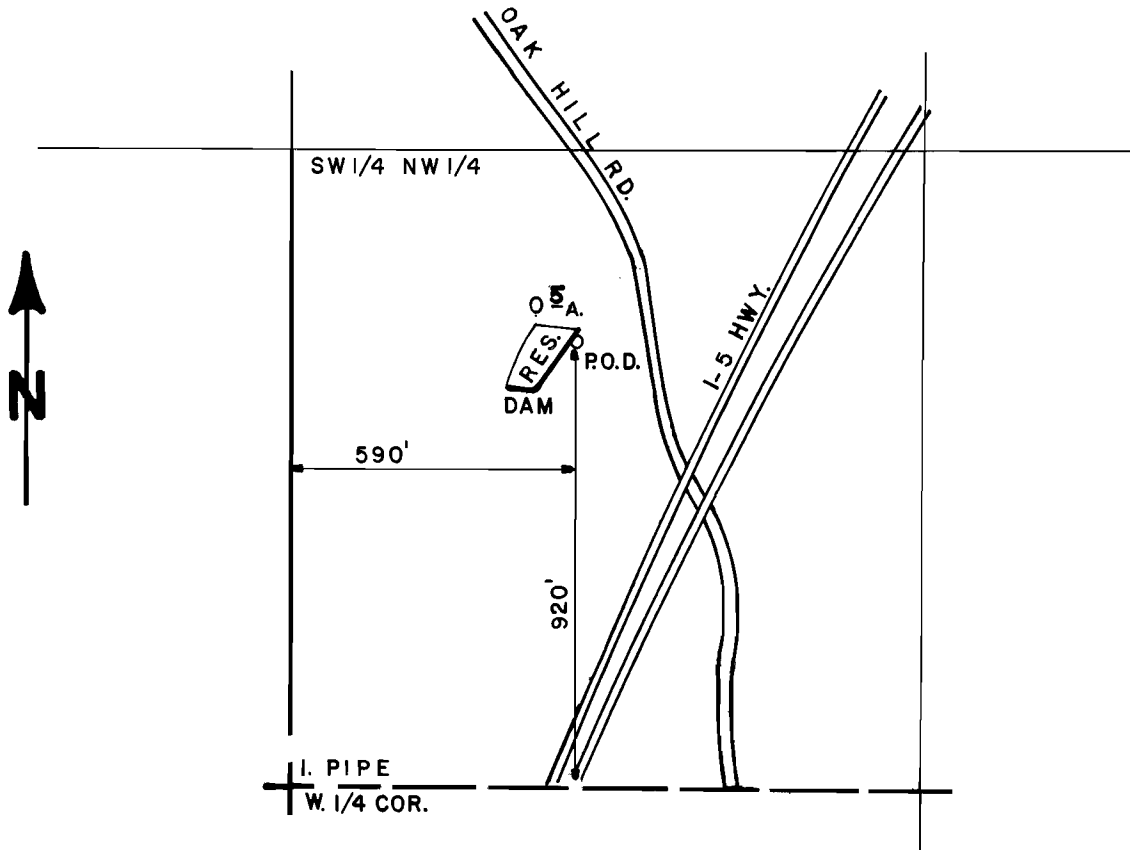

SCALE: 1" = 400'

### FINAL PROOF SURVEY UNDER

Application No. R-63497 Permit No. R-8455  
IN NAME OF

FISCHER, FRANK W.

Surveyed JUNE 24, 1985, by J.M. SCHMORDE