

46

RECEIVED


AUG 4 1981

WATER RESOURCES DEPT
SALEM, OREGON

T.38S.R.3W.V.M.

Application No. 62115

Permit No. 45958

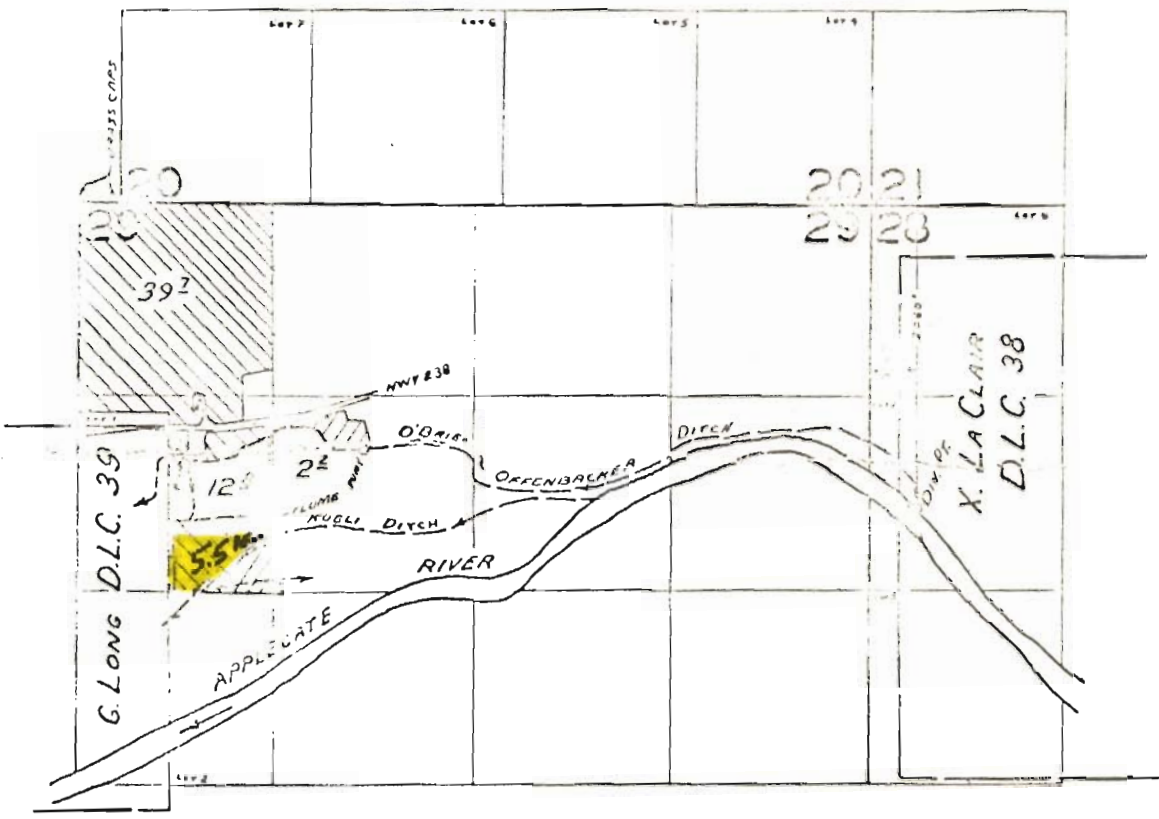

 SAMPLE
 SCHULTZ *Mark Sample*

Note: Div. Pt. location taken from Application map

FINAL PROOF SURVEY
UNDER

Map to accompany application of Claire L. Stevens to appropriate storage water from Applegate Lake Reservoir in amount of 5.5 acre feet to supplementally irrigate 5.5 acres.

Application No. 37272 Permit No. 28548
 CEN. 34037
 Priority - Dec. 21, 1965

IN NAME OF
~~GLADYS SCHULTZ~~
~~& GEORGE W. SAMPLE~~

Surveyed JUN. 24, 1965, by C. GARDNER

RECEIVED

OCT - 2 1985

WATER RESOURCES DEPT
SALEM, OREGON