


T.38 S., R.3 W., W.M.

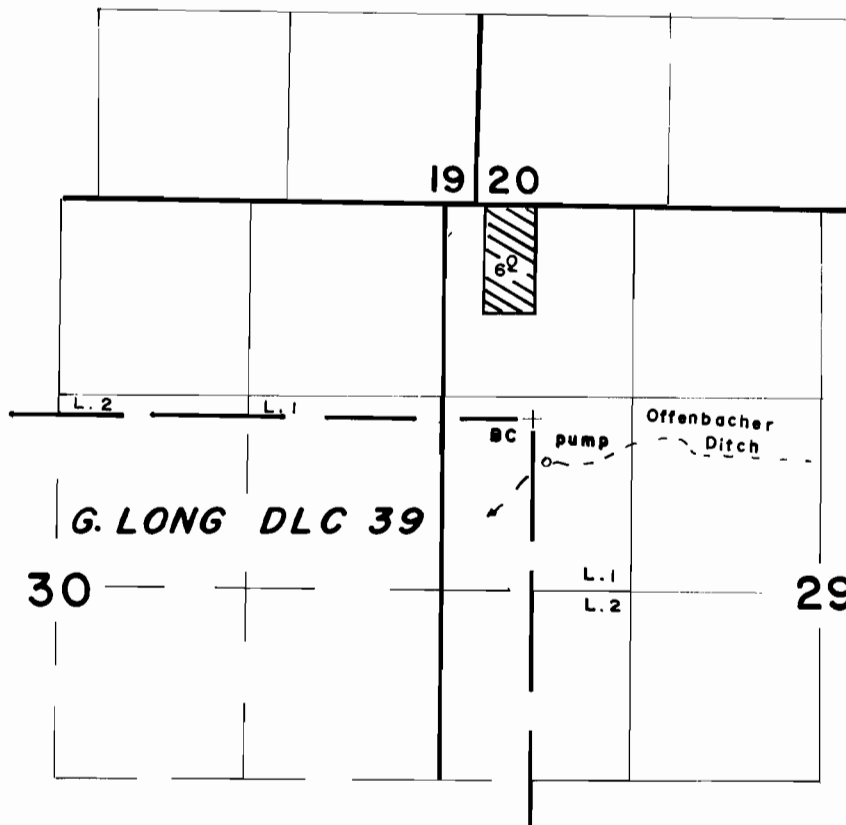

SCALE: 4" = MILE



FINAL PROOF SURVEY
UNDER

Application No. 62164 Permit No. 46024
IN NAME OF

BENGT H. HAMNER

Surveyed JUN 13 1985, by B. S. JAMES