
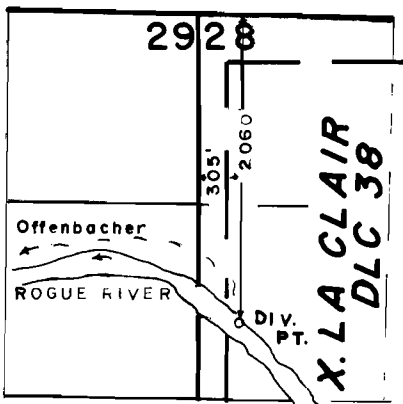


T. 38 S., R. 3 W., W. M.

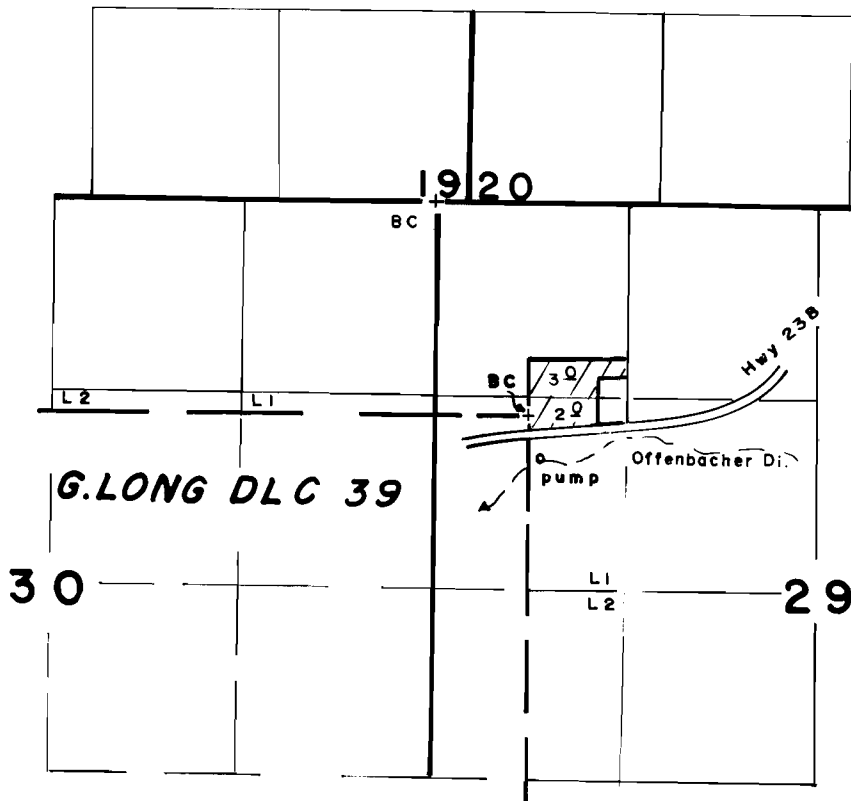

Scale: 4" = 1 Mi

**FINAL PROOF SURVEY**  
UNDER

Application No. 62191 Permit No. 46072  
IN NAME OF

GREG J. & CLAUDIA S. PEREIRA

Surveyed JUNE.13. 19.85, by B. S. JAMES...