

Application No. 62146
Permit No. 46377

38.

Application No. 37843
Permit No. 23212
Certificate No. 39819
~~SUPERSEEDING~~


T. 40 S. R. 3 W. W. M.

Wind in Applegate River, Vol. 6
Priority July 24, 1962.

RECEIVED

AUG. 6 1981

WATER RESOURCES DEPT
SALEM, OREGON

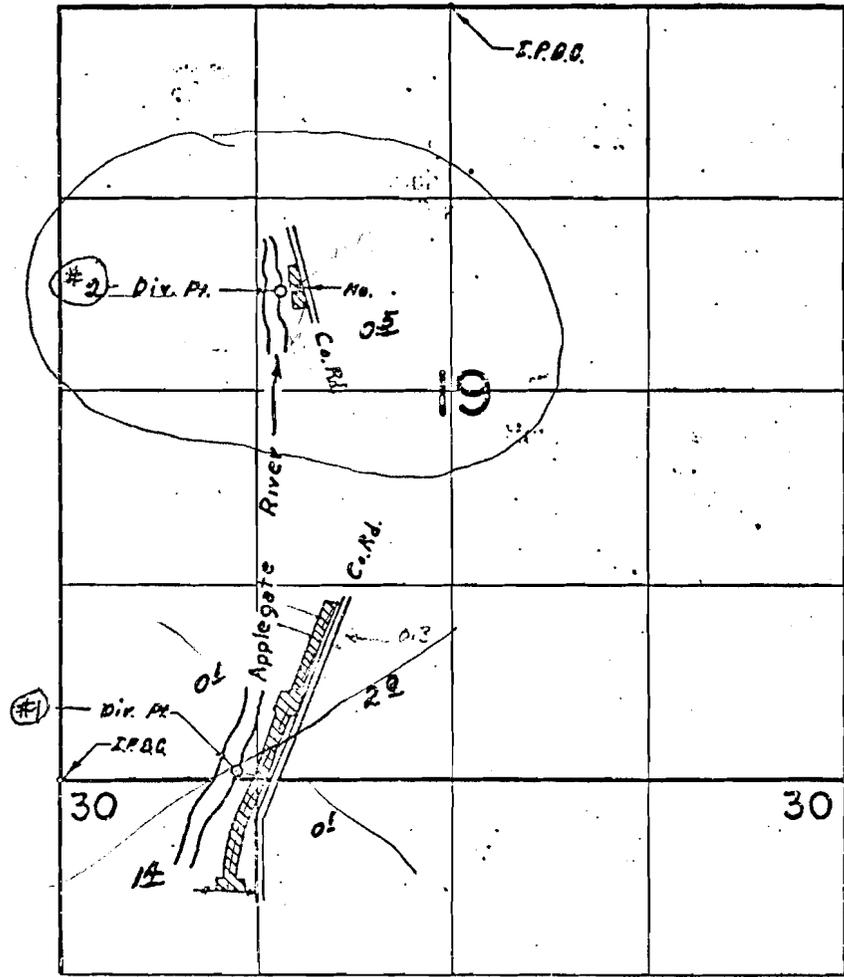

DIV. Pts. LOC.: DIV. NO. 1 - 80' N & 1190' E FROM SW COR. SEC. 19
DIV. NO. 2 - 1940' S & 1160' W FROM N 1/4 COR. SEC. 19 *J.H.*

Map to accompany application of Mrs. Gertrude Heitkamp to appropriate water from Applegate Lake Reservoir in amount of 4 acre feet to supplementally irrigate 0.5 acre of nursery type garden.

FINAL PROOF SURVEY
UNDER

Application No. 37843 Permit No. 23212
IN NAME OF

RECEIVED

OCT - 2 1985

.....MRS. GERTRUDE HEITKAMP..... WATER RESOURCES DEPT
SALEM, OREGON

Surveyed SEP. 17, 1971, by L. E. Gould

RECEIVED

NOV 24 1981
RESOURCES DEPT
SALEM, OREGON