


T.27S.,R.17E.,W.M.

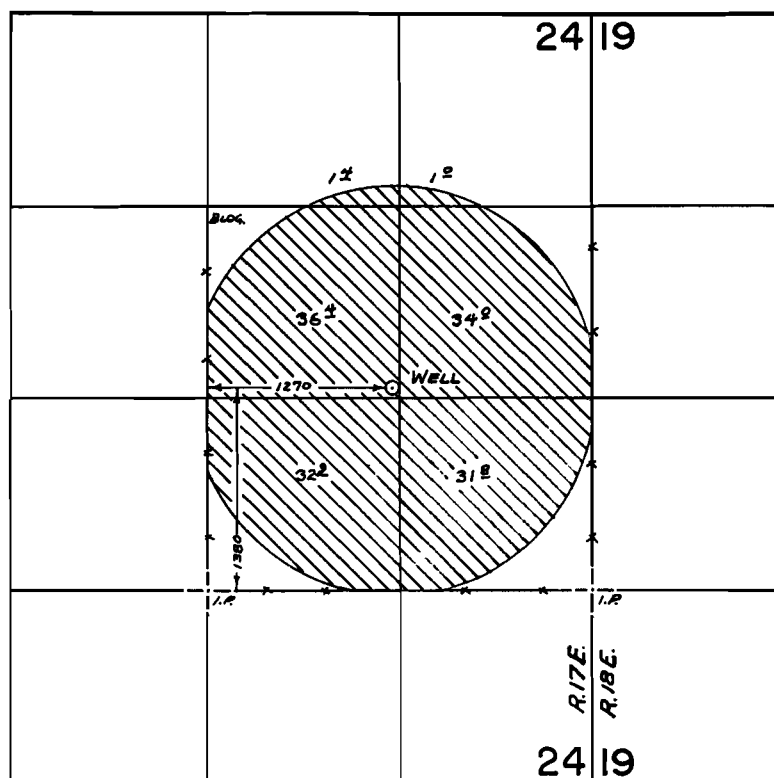

FINAL PROOF SURVEY UNDER

Application No. G-8750 Permit No. G-8198
IN NAME OF

ROBERT NORDYKE

Surveyed OCT. 27, 1981, by L. TOLL