
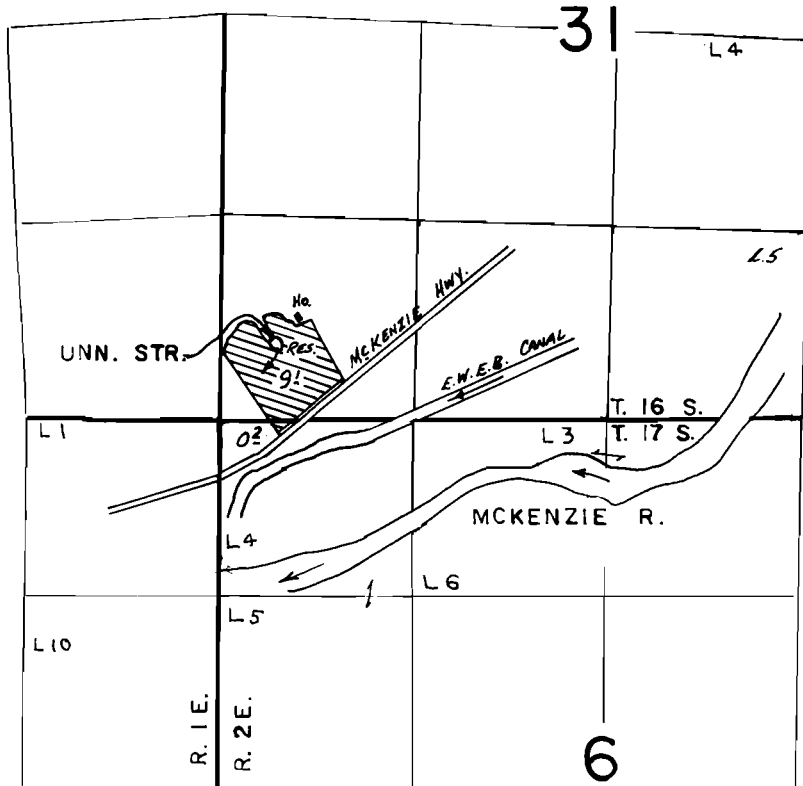


T. 16 & 17 S., R. 1 & 2 E., W.M.

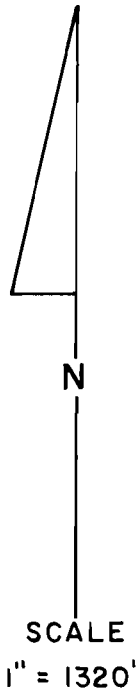

DIV. PT. LOC. 480' N & 380' E OF SW COR. SEC. 31

FINAL PROOF SURVEY UNDER

R 56504 R 6673
 Application No. 56505 Permit No. 42098
 IN NAME OF

JAMES P. & LILLIAN LAURITSON

Surveyed JUN 7 1984, by P. PAGTER