
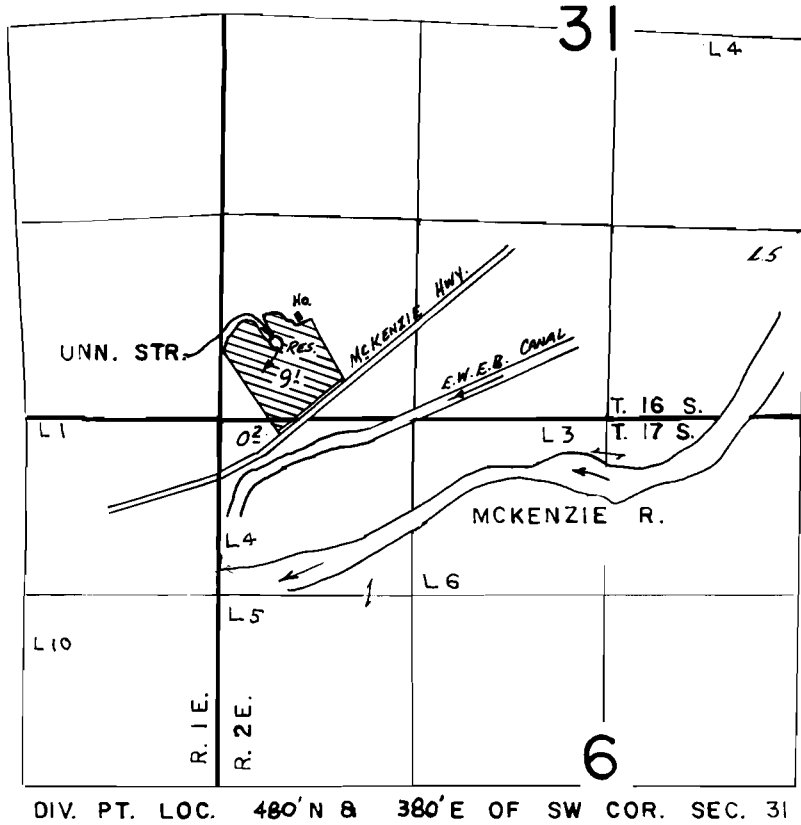


# T. 16 & 17 S., R. 1 & 2 E., W.M.

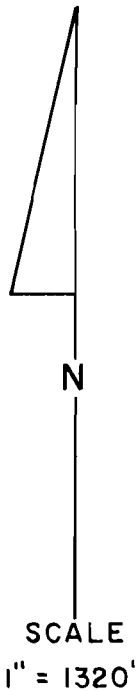

## FINAL PROOF SURVEY UNDER

R 56504                      R 6673  
 Application No. 56505    Permit No. 42098  
 IN NAME OF

JAMES P. & LILLIAN LAURITSON

Surveyed JUN 7 1984, by P. PAGTER