


T.12S., R.1W., W.M.

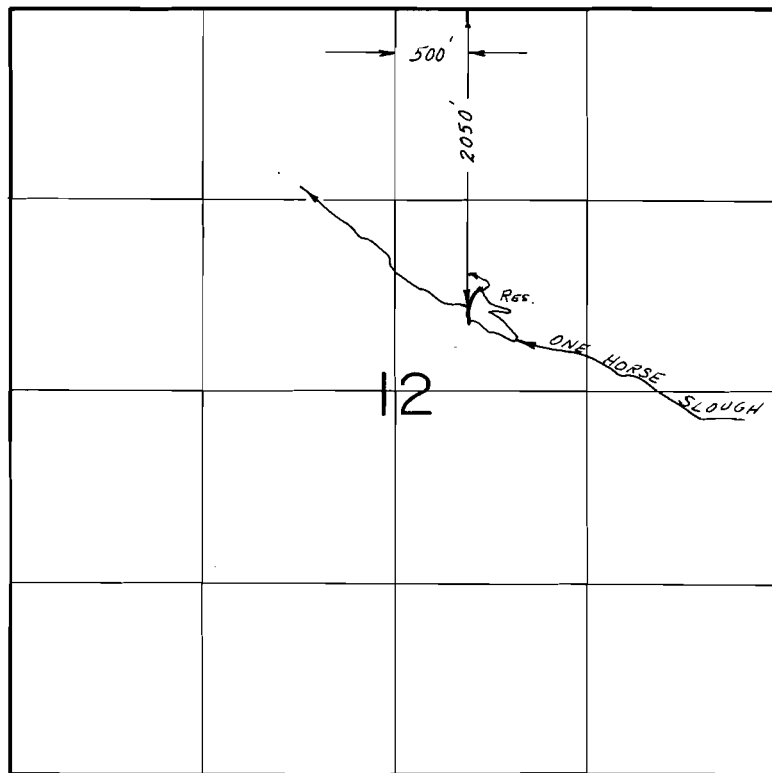

SCALE: 1" = 1320'

FINAL PROOF SURVEY
UNDER

R-58178 R-7804
Application No. 58179... Permit No. 43960...
IN NAME OF

DALE &/or COLENE STANLEY...

Surveyed June 5... 1984, by L.M. TOLL...