
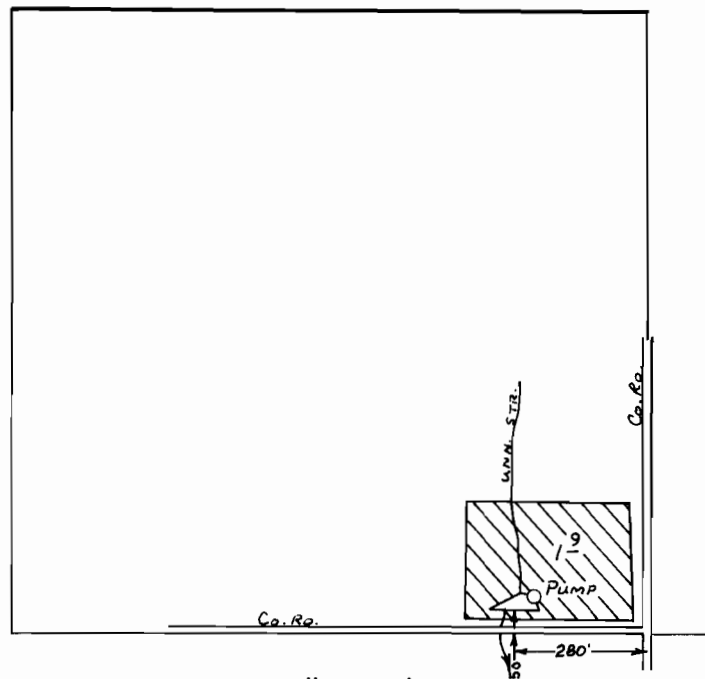


T.8S.,R.46E.,W.M.

Section 3

LOT 3 (NE 1/4 NW 1/4)

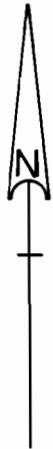

SCALE: 1" = 400'

FINAL PROOF SURVEY
UNDER

R-58674 R-7984
Application No. 58675 Permit No. 44619
IN NAME OF

SHIRLEY COYLE

Surveyed Sept. 24 1985, by L. M. TOLL