
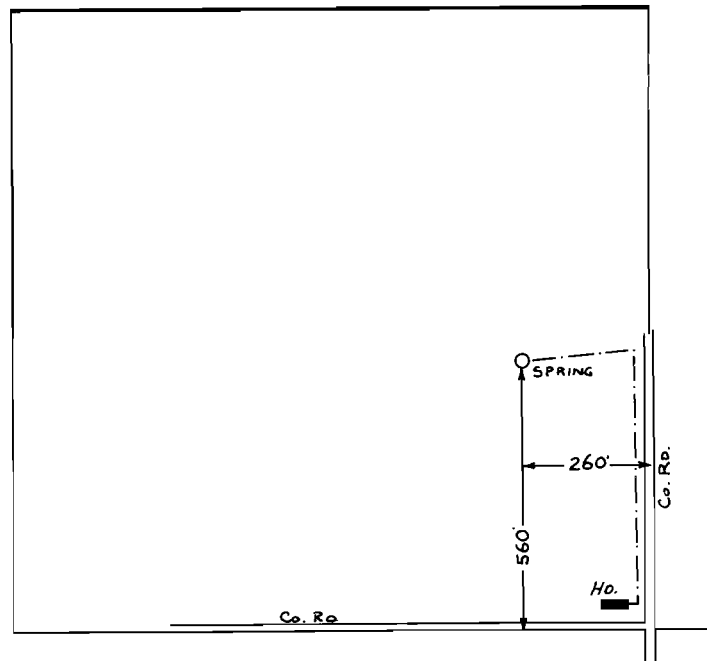


T.8S.,R.46E.,W.M.

Section 3

LOT 3 (NE 1/4 NW 1/4)

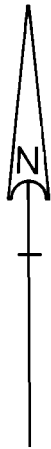

SCALE: 1" = 400'

FINAL PROOF SURVEY
UNDER

Application No. 55008.. Permit No. 41217.....
IN NAME OF

.....SHIRLEY (WRIGHT) COYLE.....

Surveyed Sept. 24.. 19.85., by L. M. TOLL.....