


T.8S.,R.46E.,W.M.

Section 3

LOT 3 (NE 1/4 NW 1/4)

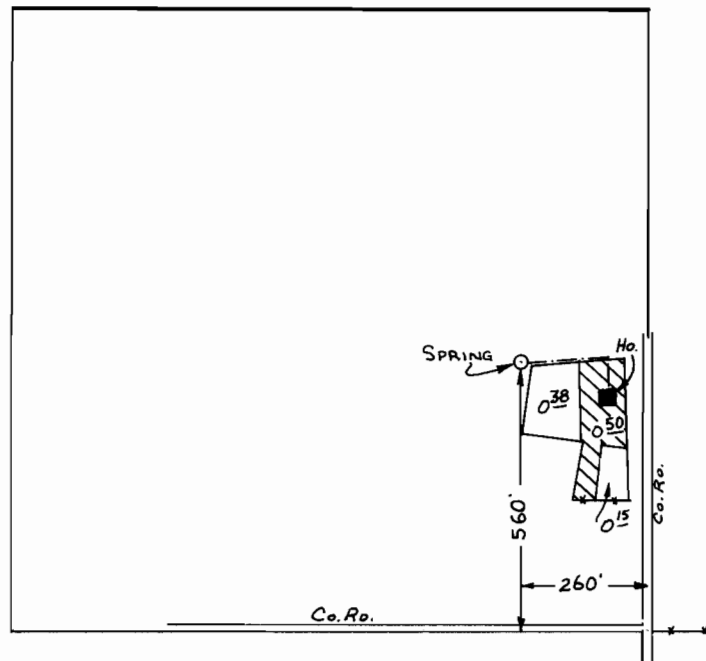

SCALE: 1" = 400'

FINAL PROOF SURVEY
UNDER

Application No. 55095.. Permit No. 41328.....
IN NAME OF

DEE & AUDREY MOORE.....

Surveyed Sept. 24. 1985., by L. M. TOLL.....