


T.7S.,R.38E.,W.M.

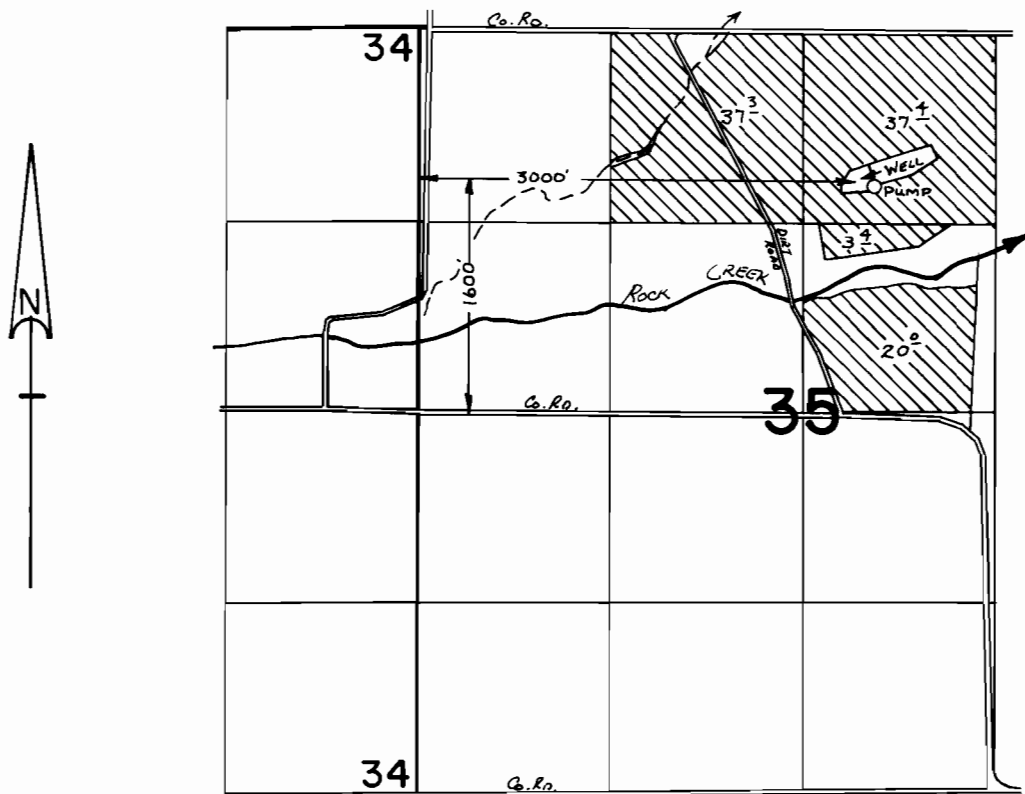

SCALE: 1" = 1320'

FINAL PROOF SURVEY UNDER

Application No. G-6875. Permit No. G-6408....
IN NAME OF

.....ROBERT D. STEPHENS.....

Surveyed July 29, 1979, by V. CHURCH & D. JARRETT

PTS 1979-P-B
888-4KK-2024222
41001-179-278 R

REDRAFTED 12/9/85 LMT