


T. 7 S., R. 39 E., W. M.

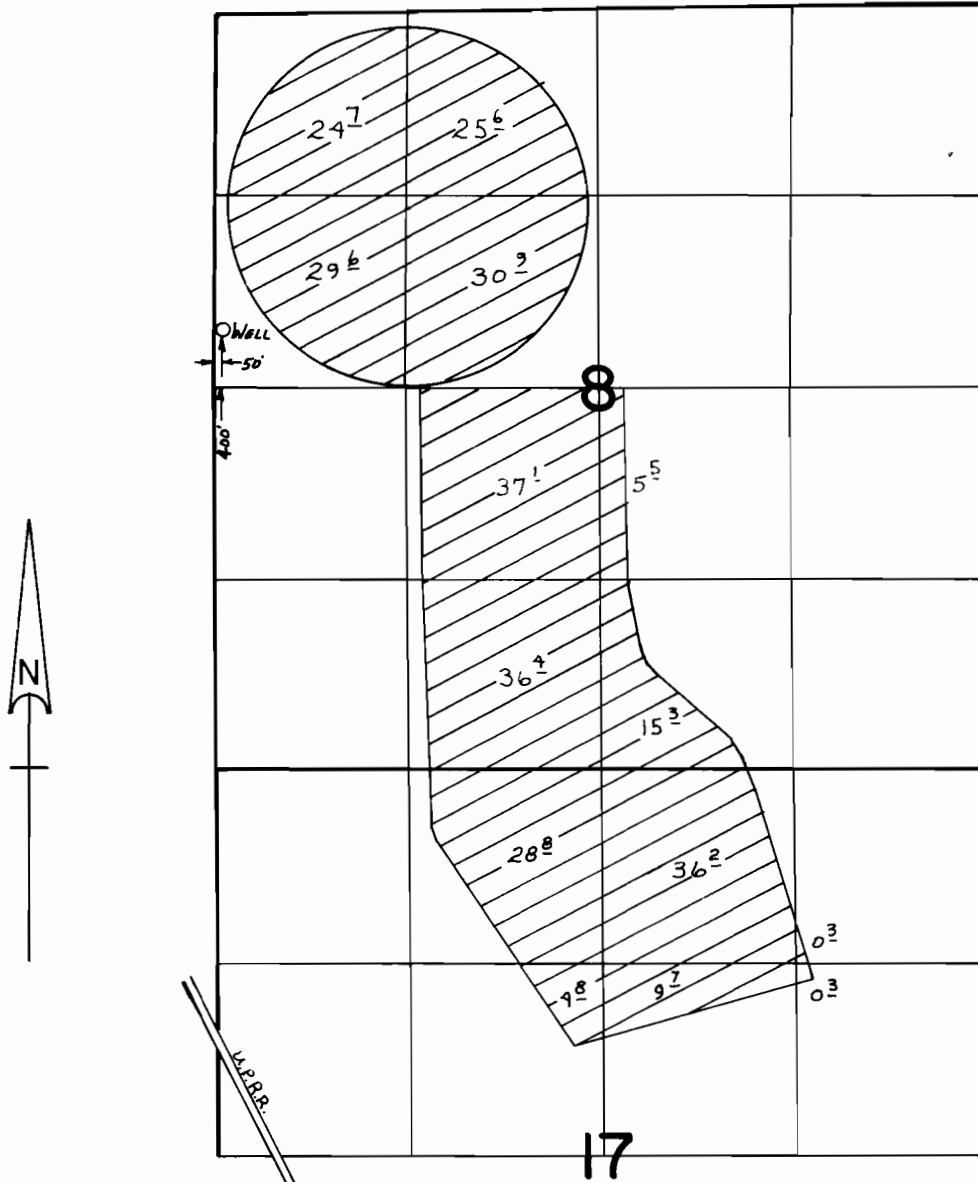

SCALE: 1" = 1320'

**FINAL PROOF SURVEY**  
UNDER

Application No. G-7050. Permit No. G-6677.....  
IN NAME OF

.....LELAND HELLBERG.....

Surveyed Oct. 2, 1980, by V. CHURCH.....

PTS-1980-P-B  
888-2N-20Z  
41001-279-B4L  
LNT  
REBRAFTED 1/16/86