


T.5S., R.1W., W.M.

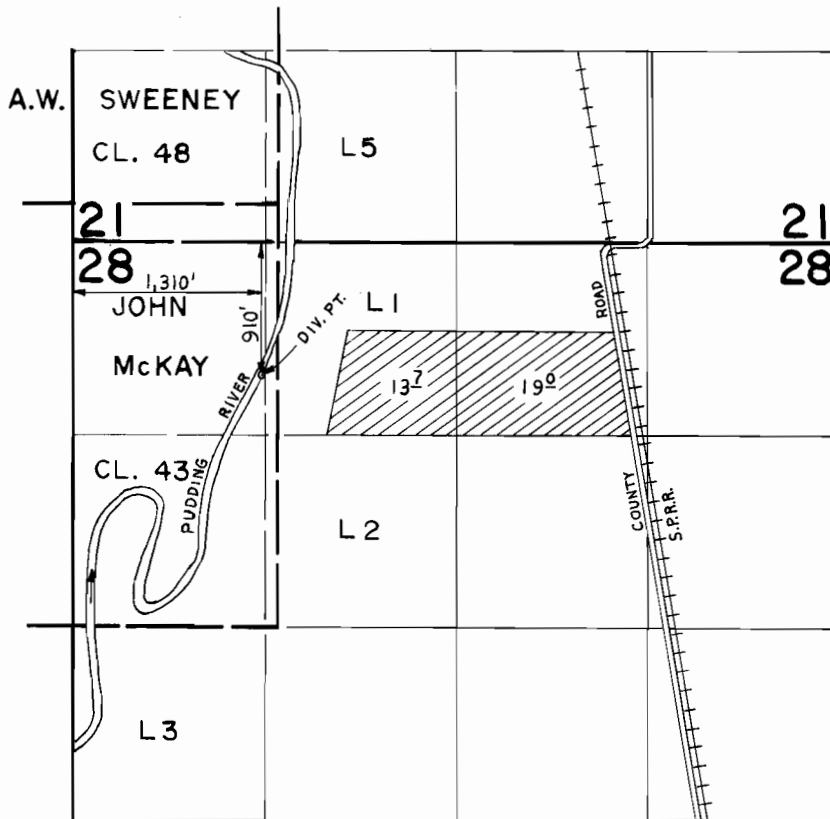

SCALE : 4" = 1 mile

FINAL PROOF SURVEY UNDER

Application No. 67974... Permit No. 48167.....
IN NAME OF

PETER J. & MARIE WEINACHT

Surveyed AUG. 29, 1985., by B. BISHOP.....