


# T. 6 S., R. 1 W., W. M.

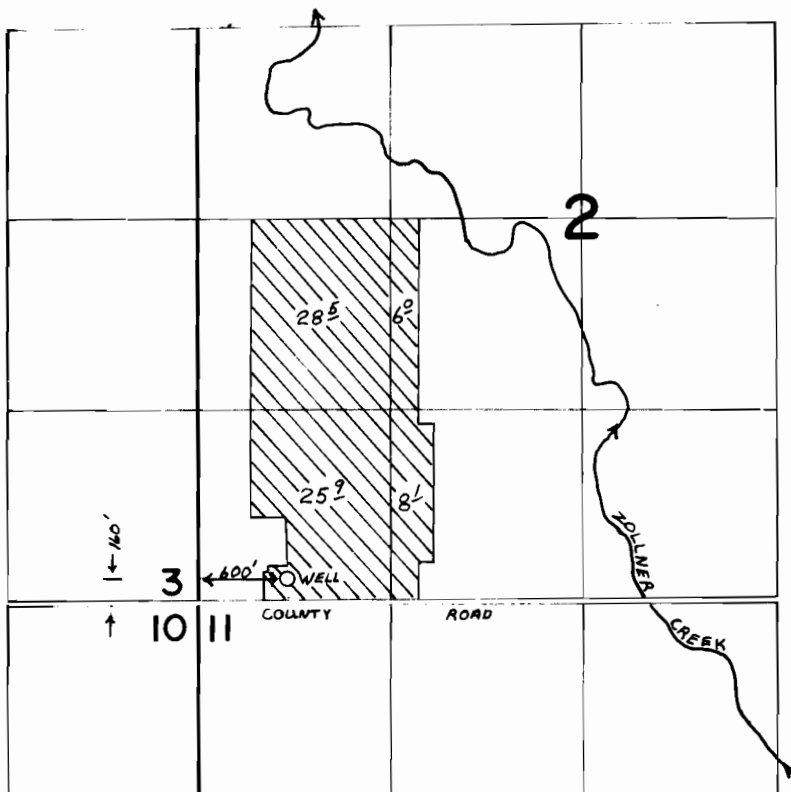

SCALE: 1"=1320'



## FINAL PROOF SURVEY UNDER

Application No. G-10845 Permit No. G-9996....  
IN NAME OF

**ALRED & ETHEL BERNING**

Surveyed Aug. 30.... 19.25., by B.W. BISHOP.....